IREDELL COUNTY HEALTH DEPARTMENT

STATESVILLE 704-878-5305 MOORESVILLE 704-664-5281

IMPROVEMENT PERMIT / AUTHORIZATION TO CONSTRUCT / OPERATION PERMIT / EXISTING SYSTEM INSPECTION

PERMIT# 27548/100546 PIN# 4628 61 3328 DATE 5/5/05

OWNER OR CONTRACTOR Darryl Nantz Building PHONE: Business 704-902-6043 Home

ADDRESS 147 Nantz Woods Ln. Troutman, NC 28166

LOCATION Manitoba Ln., 150 W TR Pinnacle Shores TR Manitoba on (R) at curve sign

SUBDIVISION Pinnacle Shores BLOCK / SECTION 1 LOT 13 LOT AREA 1.06Ac SITE CLASS. PD DESIGN FLOW 480 L.T.A.R. .3

Septic Tank: 1500 Gallons; STB 1011 Date 3/7/05
Pump Tank: 1000 Gallons; PT 17 Date 7/3/05
Pump Make: Goulds Model WE0 - 7½ H Serial No. H054B190
Nitrification Field: No Fields 1 Square Feet 810± Linear Feet 270
No Lines 3@90' Trench Width 3' Max Trench Bottom Depth 3' Gravel Depth No

☒ New System ☐ Repair System Type: I, II, III, ☒ IV, V, VI
System Description: Pres Dosed - 16" PPBPS
Repair System Description: Same System
Maintenance Agreement Required: ☐ Yes ☐ No

☒ House/Mod. Home No. Bedrooms 4
☐ Mobile Home No. Bathrooms 4
☐ Business No. Employees
☐ Other
☐ Slab ☐ Crawl Space ☒ Basement w/plumbing ☐ Basement wo/plumbing


Water Supply:
☐ Individual
☐ Public
☒ Community
Pinnacle Shores

Comments:/Conditions: Type 4 System


Comments:/Conditions:

(1" = 40')

INITIAL SITE SKETCH

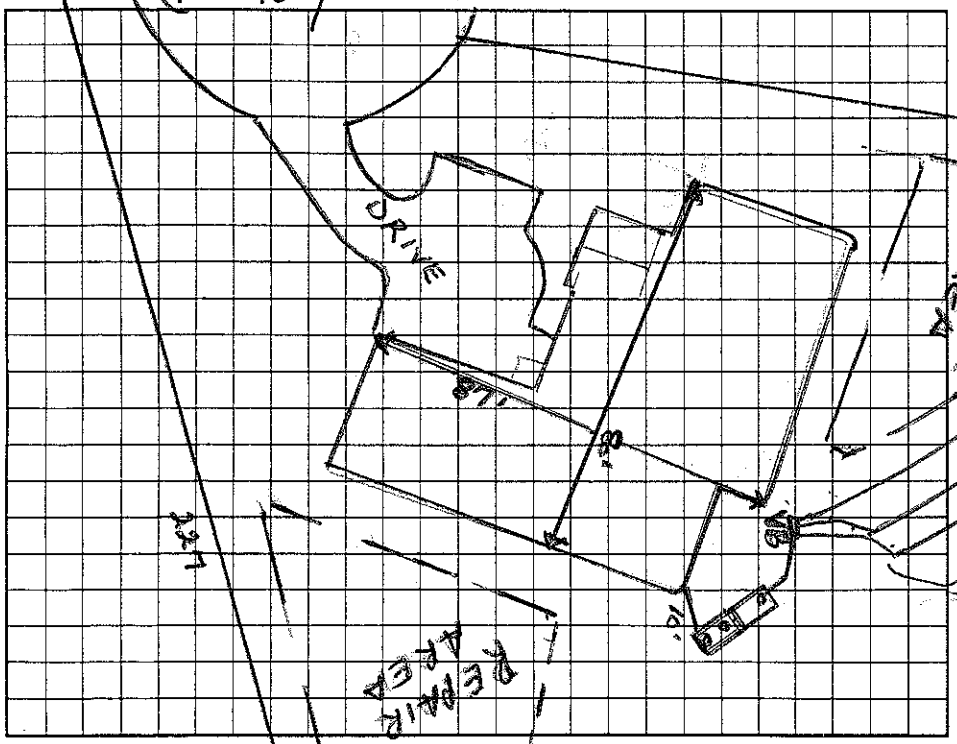

AS BUILT SKETCH

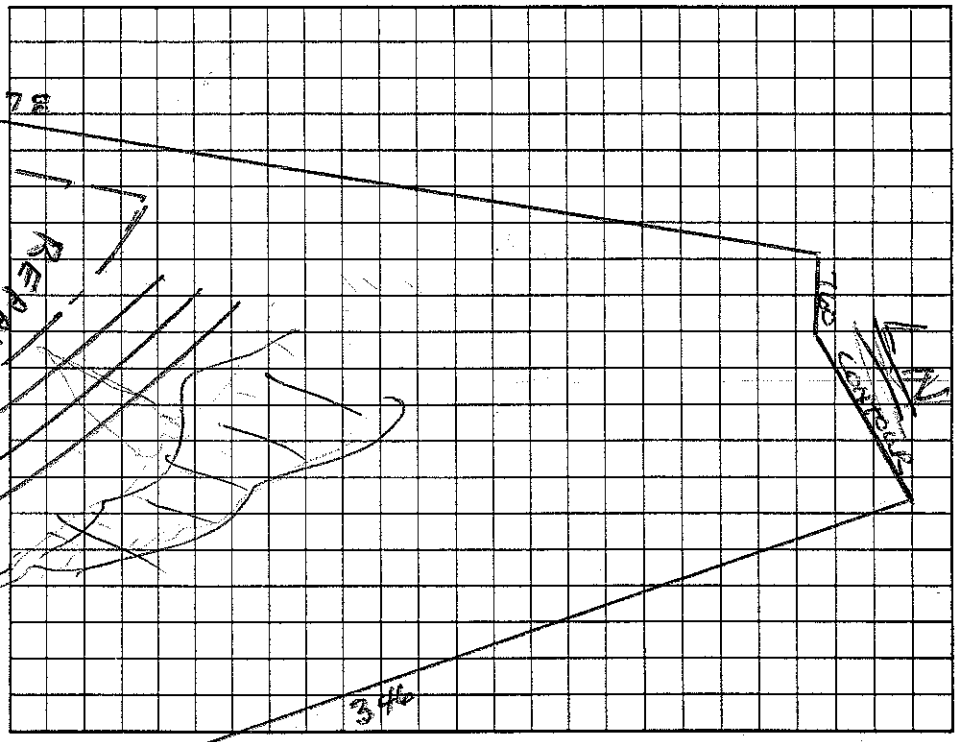

Permit can be suspended or revoked if any false information is supplied toward securing the permit/any unauthorized changes are made to the site/any unauthorized changes are made in the installation of the system. Improvement Permit with plat valid without expiration. Improvement Permit with site plan valid for sixty months. Authorization to Construct is valid for a period equal to that of Improvement Permit – not to exceed sixty months.

Signed: X [signature] date 5-6-05 Installed by: Tommy Fryc

Improvement Permit by: Wesley Sparks RS. date 5/5/05 Operation Permit by: Wesley Sparks RS. date 6/8/06

Authorization to Construct by: Wesley Sparks RS date 5/5/05 Existing System Inspection by: date

HEALTH DEPT. COPY: WHITE OWNER COPY (FINAL): YELLOW OWNER COPY (INITIAL): PINK