IREDELL COUNTY HEALTH DEPARTMENT

→ Authorization to Construct

STATESVILLE 704-878-5305 MOORESVILLE 704-664-5281

IMPROVEMENT PERMIT / ~~CERTIFICATE OF~~ COMPLETION / OPERATION PERMIT / EXISTING SYSTEM INSPECTION

PROPERTY DESCRIPTION NO. 23701 DATE 6/10/96 TAX MAP NO. 2N-8-A-19 4628 61 3764 Watershed: ☑ Yes ☐ No

OWNER OR CONTRACTOR Ed Eidam PHONE: Business 663-7115 Home 735-2679 896-3367

ADDRESS 5220 Hwy 73 Iron Station 28080

LOCATION 150 W-TR Pinnacle Shores Dr

SUBDIVISION Pinnacle Shores BLOCK / SECTION ____ LOT 19 LOT AREA ____ SITE CLASS. R5 DESIGN FLOW 360gpd L.T.A.R. 1.3gpd/ft

Septic Tank: 1000 Gallons; STB 794 Date 11/7/96

Pump Tank: 1000 Gallons; PT 27 Date 10/3/96

Pump Make: HYDROMATIC Model .75 HP Serial No. ____

Nitrification Field: No Fields 1 Square Feet 1200 Linear Feet 400

No Lines 6 Trench Width 36" Max Trench Bottom Depth 36" Gravel Depth 12"

☑ New System ☐ Repair System Type: I, II, III, IV, V, VI

System Description: Pump Conv.

Repair System Description: D Pump Chamber

Maintenance Agreement Required: ☐ Yes ☑ No

☑ House/Mod. Home No. Bedrooms 3

☐ Mobile Home No. Bathrooms 2

☐ Business No. Employees ____

☐ Other ____


☐ Slab ☐ Crawl Space ☑ Basement w/plumbing ☐ Basement wo/plumbing

Water Supply: ☐ Individual ☑ Community ☐ Public


Comments:

Comments: INSTALLED AS SHOWN BUT 6 @ 67°

INITIAL SITE SKETCH 111 > 60'

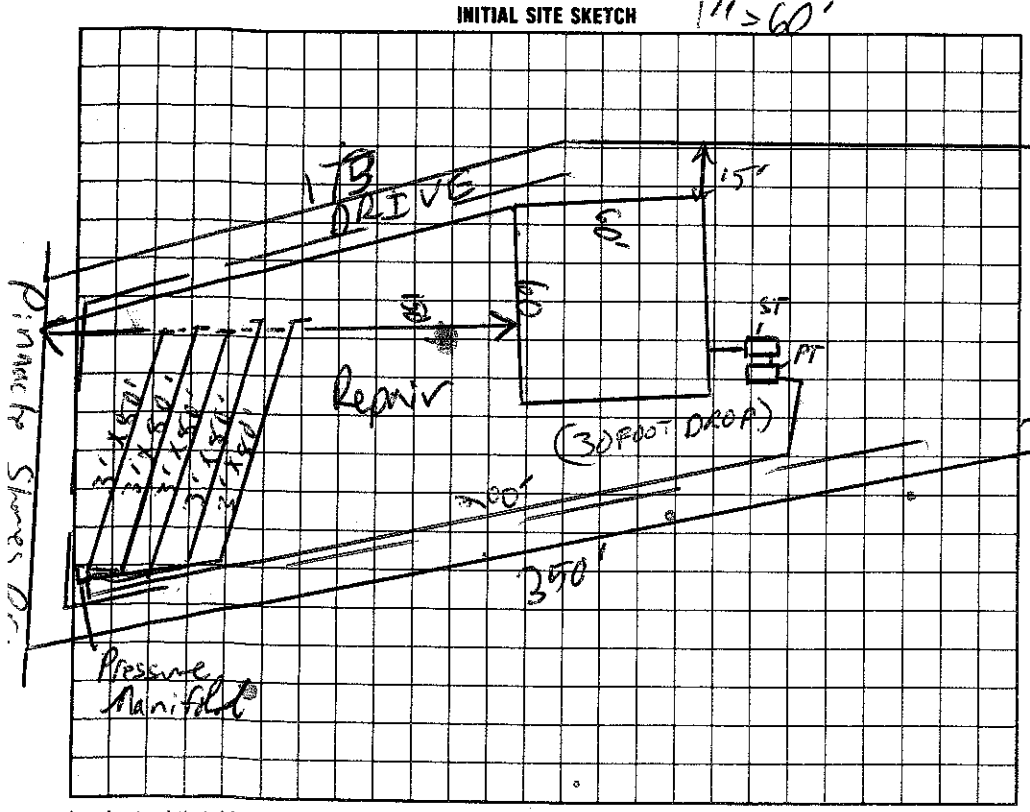

AS BUILT SKETCH

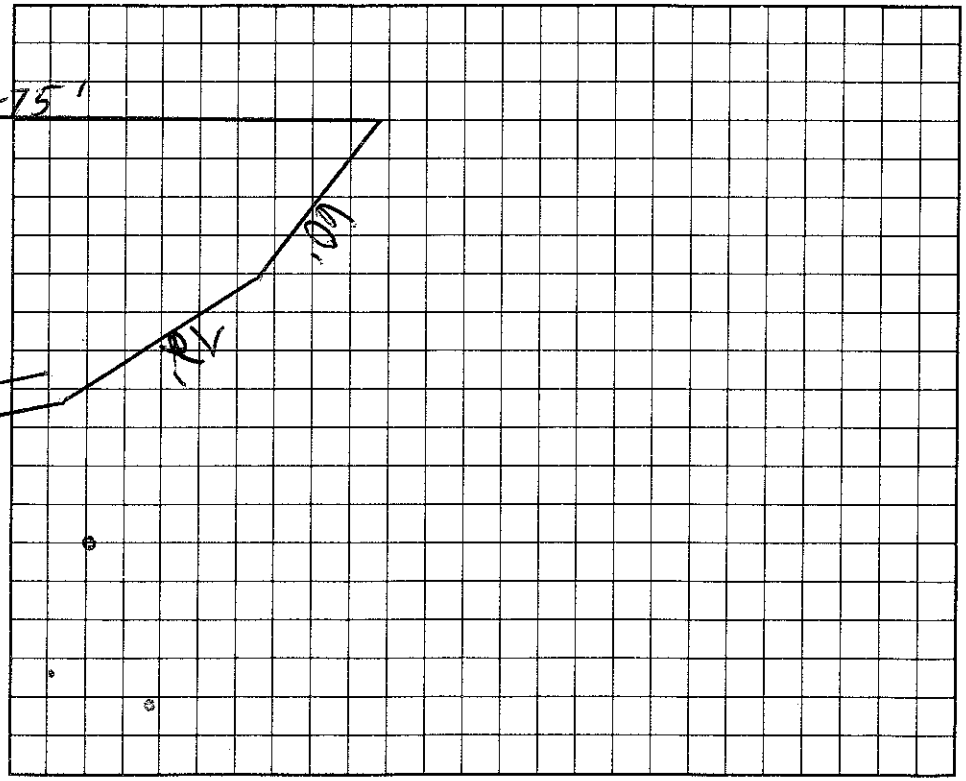

I understand that this permit can be suspended or revoked if any false information is supplied toward securing the permit/any unauthorized changes are made to the site/any unauthorized changes are made in the installation of the system.

Signed: Edward M. Eidam

Improvement Permit by: C. Bobby Stevens EHSI date 6/10/96

Existing System Inspection by: C. Bobby Stevens EHSI date 6/10/96

Installed by: KEN DELLINGER

Certificate of Completion by: ____ date ____

Operation Permit by: C. Bobby Stevens date 2/20/97

HEALTH DEPT. COPY: WHITE INSPECTION COPY (FINAL): GREEN OWNER COPY (FINAL): YELLOW INSPECTION COPY (INITIAL): PINK OWNER COPY (INITIAL): GOLD

Authorization to Construct is Valid for 60 months from issue date.