IREDELL COUNTY HEALTH DEPARTMENT → AUTH TO CONSTRUCT

STATESVILLE 704-878-5305 MOORESVILLE 704-664-5281

IMPROVEMENT PERMIT / ~~CERTIFICATE OF COMPLETION~~ / OPERATION PERMIT / EXISTING SYSTEM INSPECTION

PROPERTY DESCRIPTION NO. 25676 DATE 12/20/96 TAX MAP NO. 2N-8-A-20 4628 61 4862 Watershed: ☐ Yes ☐ No

OWNER OR CONTRACTOR BARRY ~~SWARTZ~~ SCHWARTZ PHONE: Business ______ Home 543-5250

ADDRESS 7600 BRYAN STONE CT CHARLOTTE

LOCATION 150 - TR PINNACLE SHORES DR - 3rd LOT ON RT PAST MANITOBA

SUBDIVISION PINNACLE SHORES BLOCK / SECTION ______ LOT 20 LOT AREA 1.112 AC SITE CLASS. PS DESIGN FLOW 480 GPD L.T.A.R. .3 GPD/FT²

Septic Tank: 1000 Gallons; STB 794 Date 12/17/98

Pump Tank: 1000 Gallons; PT 27 Date 1/12/99

Pump Make: Gould Model WE-1012H Serial No. F9858224

Nitrification Field: No Fields 1 Square Feet 1260 Linear Feet 420

No Lines 6 @ 70 Trench Width 36" Max Trench Bottom Depth 36" Gravel Depth N/A

☑ New System ☐ Repair System Type: I, II, (III), IV, V, VI

System Description: PUMP CHAMBERED OR SIMILAR

Repair System Description: PUMP PANEL

Maintenance Agreement Required: ☐ Yes ☑ No

☑ House/Mod. Home ☐ Mobile Home ☐ Business ☐ Other ______

No. Bedrooms 4 No. Bathrooms 4 No. Employees ______


☐ Slab ☑ Crawl Space ☐ Basement w/plumbing ☐ Basement wo/plumbing

Water Supply: ☐ Individual ☑ Community ☐ Public


Comments:

Comments:

INITIAL SITE SKETCH 1" = 100'

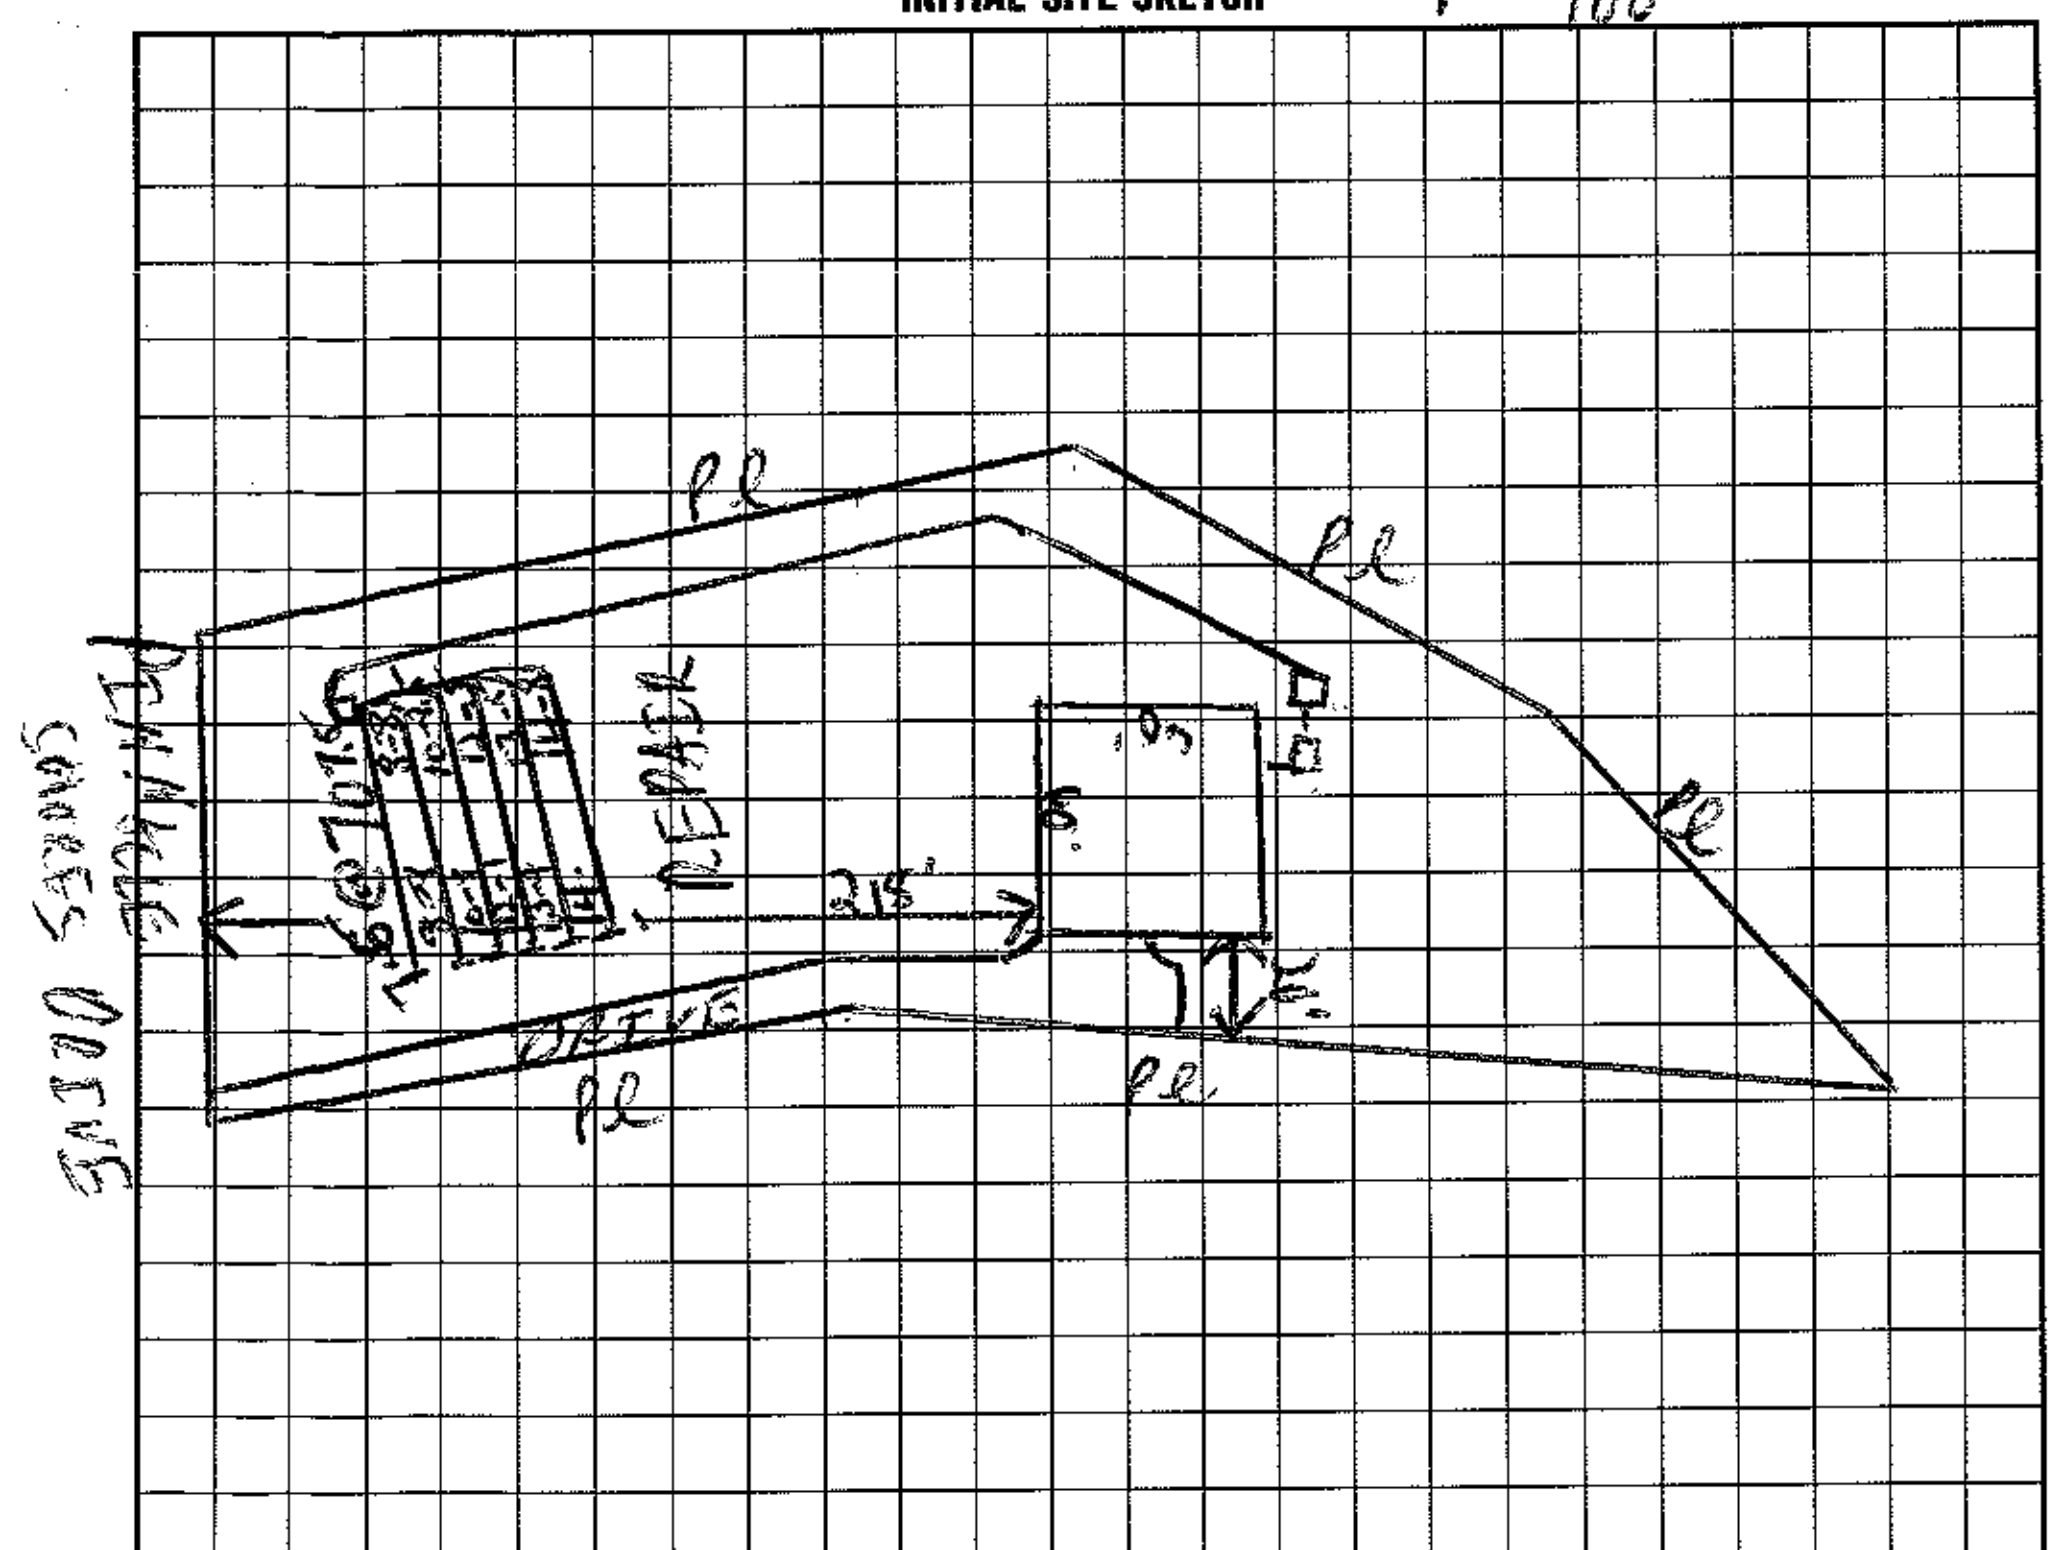

AS BUILT SKETCH

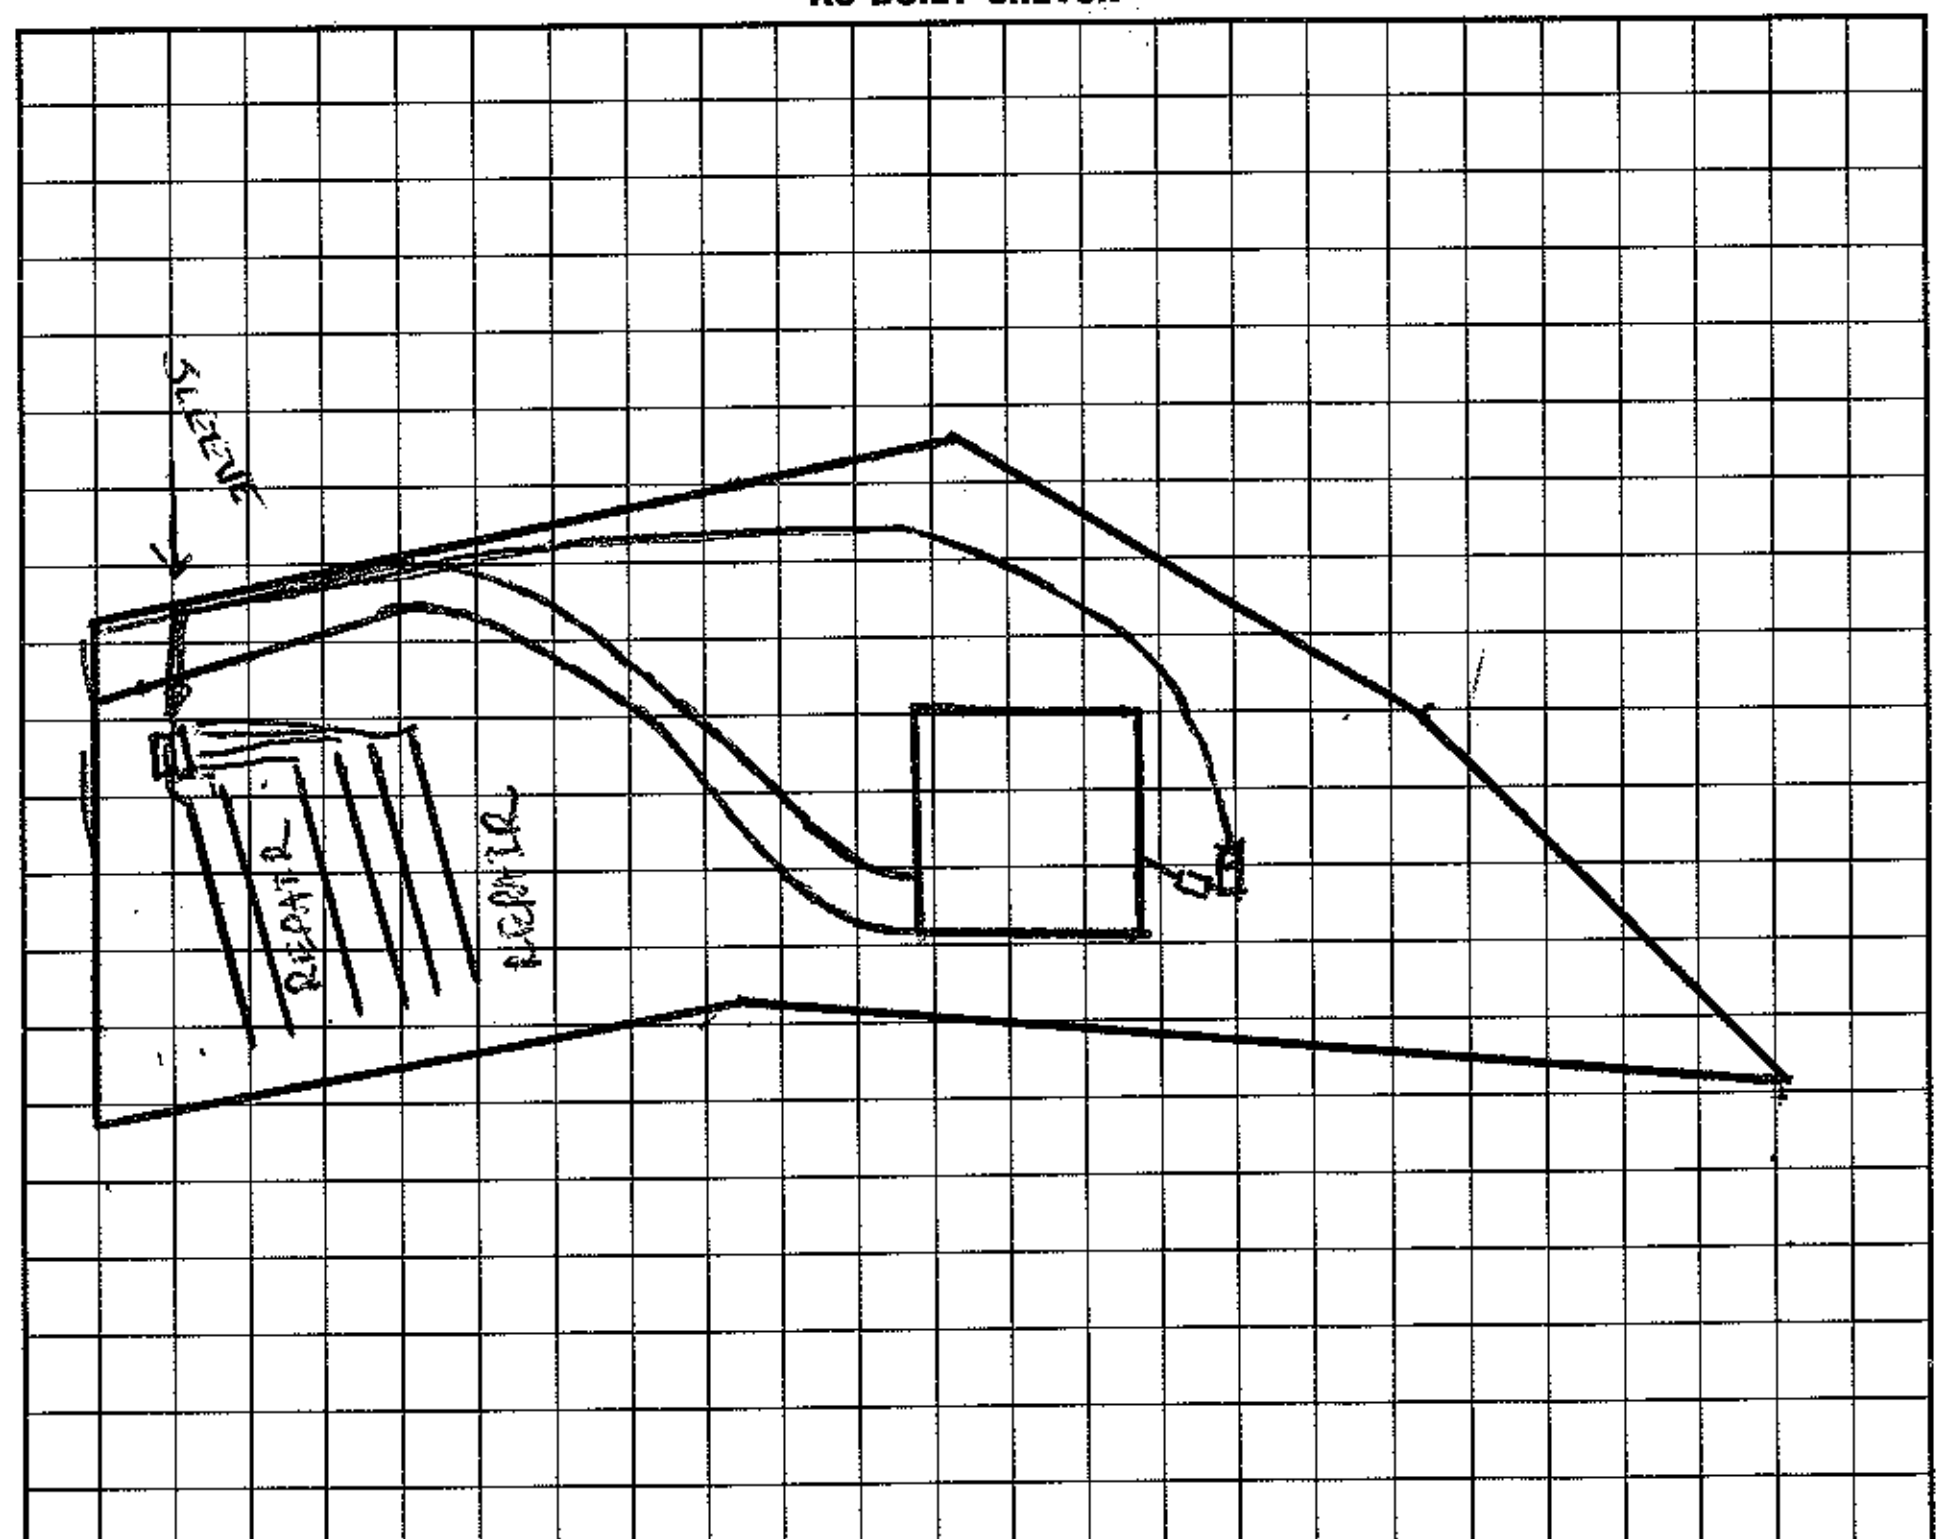

I understand that this permit can be suspended or revoked if any false information is supplied toward securing the permit/any unauthorized changes are made to the site/any unauthorized changes are made in the installation of the system.

Signed: Barry Schwartz

Improvement Permit by: C. [signature] EHS date 12/20/96

AUTH. TO CONSTRUCT ~~Existing System Inspection~~ by: C. [signature] EHS date 12/20/96

Installed by: FJ Erwin

Certificate of Completion by: ______ date ______

Operation Permit by: Wesley Sparks RS date 3/25/99

HEALTH DEPT. COPY: WHITE INSPECTION COPY (FINAL): GREEN OWNER COPY (FINAL): YELLOW INSPECTION COPY (INITIAL): PINK OWNER COPY (INITIAL): GOLD