IREDELL COUNTY HEALTH DEPARTMENT

STATESVILLE 704-878-5305 MOORESVILLE 704-664-5281

IMPROVEMENT PERMIT / CERTIFICATE OF COMPLETION / OPERATION PERMIT / EXISTING SYSTEM INSPECTION

Panel without Cover

(1:30) ~~11:30~~

PROPERTY DESCRIPTION NO. 21304 DATE Dec 11 '95 TAX MAP NO. part of 2NA20 4628 61 5452 Watershed: ☑ Yes ☐ No

OWNER OR CONTRACTOR Crescent Resources clo Robert D. Jones PHONE: Business _____ Home _____ WS4CA

ADDRESS PO Box 1003, Charlotte

LOCATION 150 N TR Pinnacle Shores DR.

SUBDIVISION Pinnacle Shores BLOCK / SECTION _____ LOT 14, 14A LOT AREA > 20,000 ft² SITE CLASS. PSpec.1956 DESIGN FLOW 480 gpd L.T.A.R. .3

Septic Tank: 1000 Gallons; STB 704 Date 5/25/96

Pump Tank: 1000 Gallons; PT 27 Date 10/19/96

Pump Make: _____ Model _____ Serial No. _____

Nitrification Field: No Fields 1 Square Feet 1200 Linear Feet 400

No Lines 4@100' Trench Width 36" Max Trench Bottom Depth 36"

☐ New System ☐ Repair System Type: I, II, ☑ III, IV, V, VI

System Description: pumped-pw-Infiltrator 14A

Repair System Description: LP Panel 14A

Maintenance Agreement Required: ☐ Yes ☑ No initially

Gravel Depth N/A

☑ House/Mod. Home ☐ Mobile Home ☐ Business ☐ Other

No. Bedrooms 4 No. Bathrooms 4 No. Employees _____


☐ Slab ☐ Crawl Space ☑ Basement w/plumbing ☐ Basement wo/plumbing

Water Supply: ☐ Individual ☑ Community ☐ Public


Comments:

Comments: LINES & TANKS CHECKED 12/11/96. CF

INITIAL SITE SKETCH Not to scale

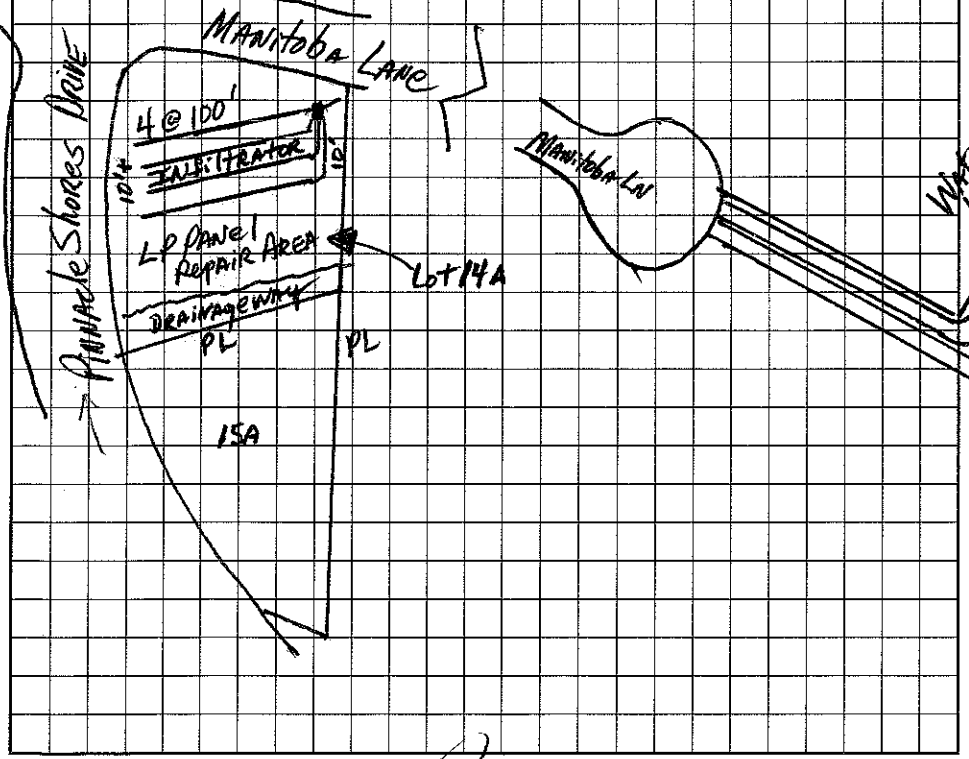

AS BUILT SKETCH

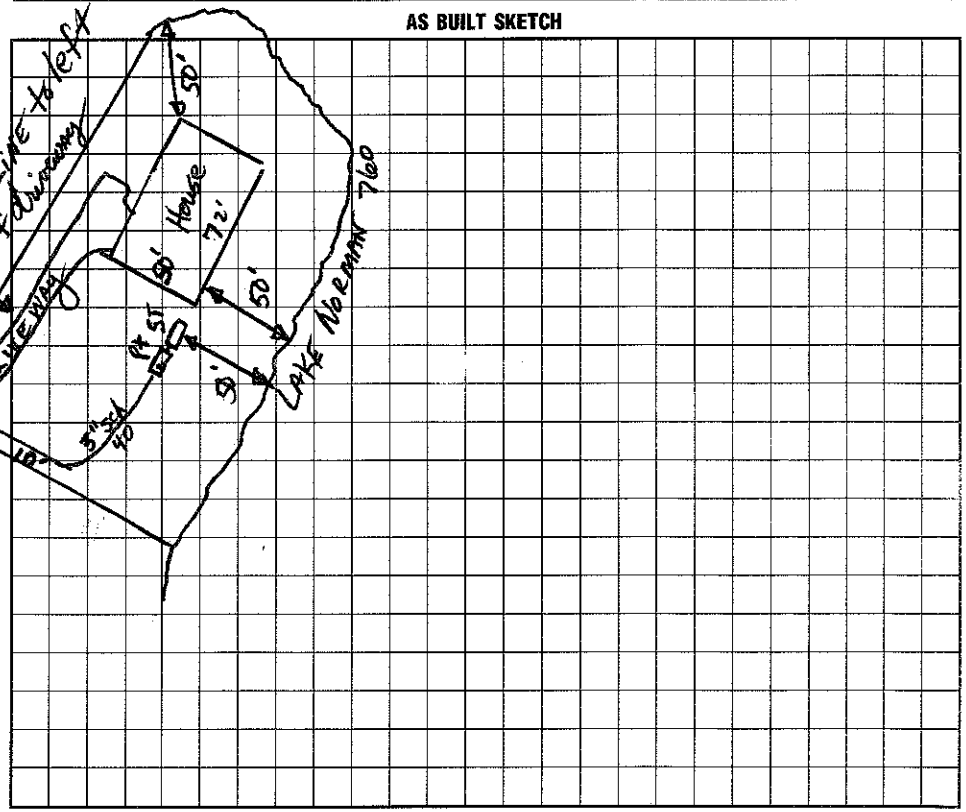

I understand that this permit can be suspended or revoked if any false information is supplied toward securing the permit/any unauthorized changes are made to the site/any unauthorized changes are made in the installation of the system.

Signed: [signature] COES Agent Installed by: Tim Ammons

Improvement Permit by: [signature] RS date 12-11-95

Certificate of Completion by: _____ date _____

~~Existing System Inspection by:~~ Construction Authorization [signature] RS date 6-10-96

Operation Permit by: Wesley Sparks RS. date 1/14/97

HEALTH DEPT. COPY: WHITE INSPECTION COPY (FINAL): GREEN OWNER COPY (FINAL): YELLOW INSPECTION COPY (INITIAL): PINK OWNER COPY (INITIAL): GOLD