4628-61-6829

IREDELL COUNTY HEALTH DEPARTMENT

STATESVILLE 704-878-5305 MOORESVILLE 704-664-5281

IMPROVEMENT PERMIT / CERTIFICATE OF COMPLETION / OPERATION PERMIT / EXISTING SYSTEM INSPECTION

PROPERTY DESCRIPTION NO. 21309 DATE Aug 2, '95 TAX MAP NO. part of 2814-20 Watershed: ☑ Yes ☐ No

OWNER OR CONTRACTOR Crescent Resources, LLC Eric Taylor PHONE: Business _____ Home _____

ADDRESS PO Box 1033, Charlotte

LOCATION 150 W TR Pinnacle Shores Dr. TR Shelter Cove Lane 3rd lot on Right

SUBDIVISION Pinnacle Shores BLOCK / SECTION I LOT 23 LOT AREA 20,780ft² + SITE CLASS. Pre 1996 DESIGN FLOW 480gpd L.T.A.R. .3

Septic Tank: 1000 Gallons; STB 312 Date 7/10/00

Pump Tank: 1000 Gallons; PT 27 Date 7/16/00

Pump Make: MYERS Model WE0511H Serial No. _____

Nitrification Field: No Fields 1 Square Feet _____ Linear Feet 267'

No Lines 4 Trench Width 24" Max Trench Bottom Depth ≈30" Gravel Depth NA

☑ New System ☐ Repair System Type: I, II, III, ⓥ V, VI

System Description: LPPPBRS

Repair System Description: same

Maintenance Agreement Required: ☑ Yes ☐ No partial

☐ Slab ☑ Crawl Space ☑ Basement w/plumbing ☐ Basement wo/plumbing

☑ House/Mod. Home No. Bedrooms 4/4

☐ Mobile Home No. Bathrooms

☐ Business No. Employees


☐ Other

Water Supply: ☐ Individual ☑ Community ☐ Public

Comments: 9/14/00 Supply line on (L) instead of (R) side of lot.

Comments: DEVELOPER 4 Bedrooms 147 PERMIT 7.5 hundreds = 5" Taylor

INITIAL SITE SKETCH 1"=50'

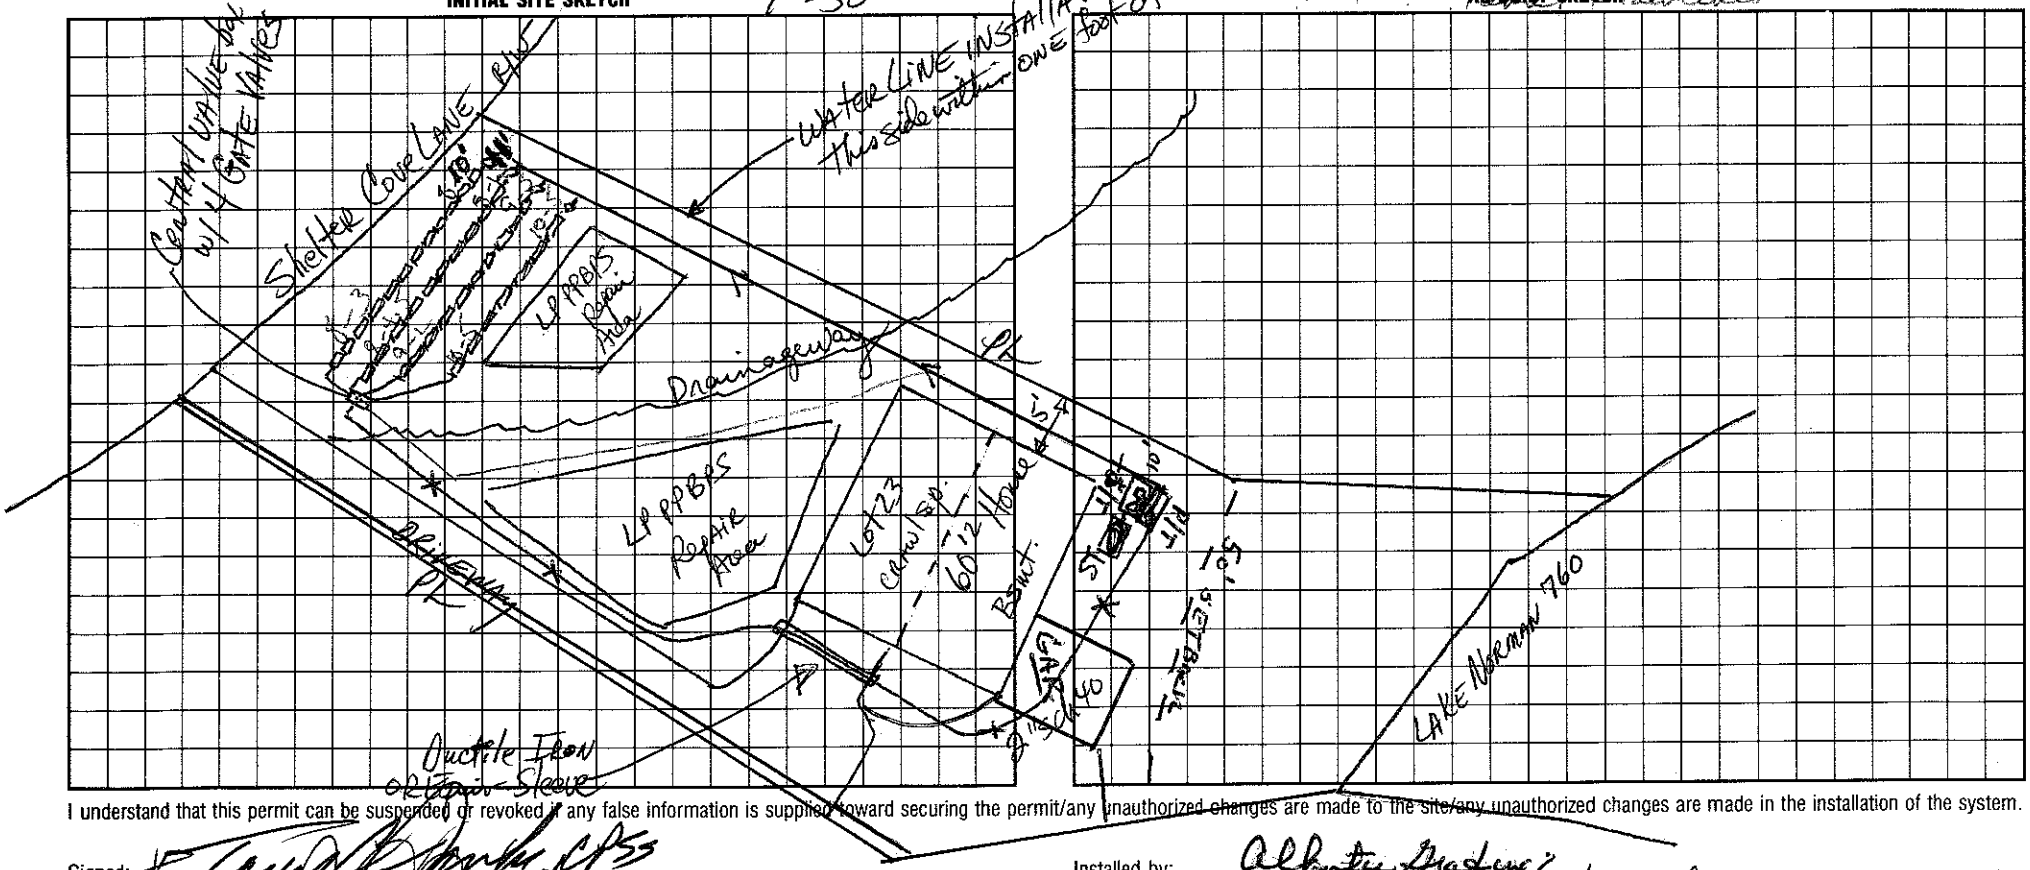

AS BUILT SKETCH

I understand that this permit can be suspended or revoked if any false information is supplied toward securing the permit/any unauthorized changes are made to the site/any unauthorized changes are made in the installation of the system.

Signed: _____

Improvement Permit by: _____ date 8-7-95

Existing System Inspection by: Wesley Sparks R.S. date 9/14/00

Installed by: Alberties Gardening

Certificate of Completion by: Maria Dotson R.S. date 3/23/2001

Operation Permit by: Maria Dotson R.S. date 3/23/2001

HEALTH DEPT. COPY: WHITE INSPECTION COPY (FINAL): GREEN OWNER COPY (FINAL): YELLOW INSPECTION COPY (INITIAL): PINK OWNER COPY (INITIAL): GOLD