IREDELL COUNTY HEALTH DEPARTMENT

STATESVILLE 704-878-5305 MOORESVILLE 704-664-5281

IMPROVEMENT PERMIT / AUTHORIZATION TO CONSTRUCT / OPERATION PERMIT / EXISTING SYSTEM INSPECTION

2,100

DATE 10-21-2002

PERMIT# 109104 PIN# 4628161 7830

OWNER OR CONTRACTOR ABJ Construction PHONE: Business 664-4353 Home

ADDRESS 1184 Brawley School Rd. Mooresville, NC 28115

LOCATION Hwy 150 West TR Pinnacle Shores Dr TR Shelter Cove Ln 4th lot on right

SUBDIVISION Pinnacle Shores BLOCK / SECTION I LOT 24 LOT AREA 1.03 Acre SITE CLASS. PS DESIGN FLOW 480gpd L.T.A.R. .3

Septic Tank: 1000 Gallons; STB 914 Date 6-1-02

Pump Tank: 1000 Gallons; PT 1213 Date 12-16-02

Pump Make: Goulds Model WE1012H Serial No. S03919345

Nitrification Field: No Fields 1 Square Feet 1200' Linear Feet 400'

No Lines 5@80' Trench Width 36" Max Trench Bottom Depth 36" Gravel Depth N/A

☒ New System ☐ Repair System Type: I. II. III. IV. V. VI

System Description: Pumped/pm/Infiltrator

Repair System Description: LP Panel Block

Maintenance Agreement Required: ☐ Yes ☒ No Not initially

☐ Slab ☐ Crawl Space ☒ Basement w/plumbing ☐ Basement wo/plumbing

☒ House/Mod. Home No. Bedrooms 4

☐ Mobile Home No. Bathrooms 4

☐ Business No. Employees

☐ Other


Water Supply: ☐ Individual ☐ Public ☒ Community

Comments/Conditions: Keep Septic System at least 10' from PL & 50' from lake.


Comments/Conditions: Installed Drainfield with 11 Plastic Chambers 8/13/03
Pressure checked 8/14/03

Scale = 1:50

INITIAL SITE SKETCH

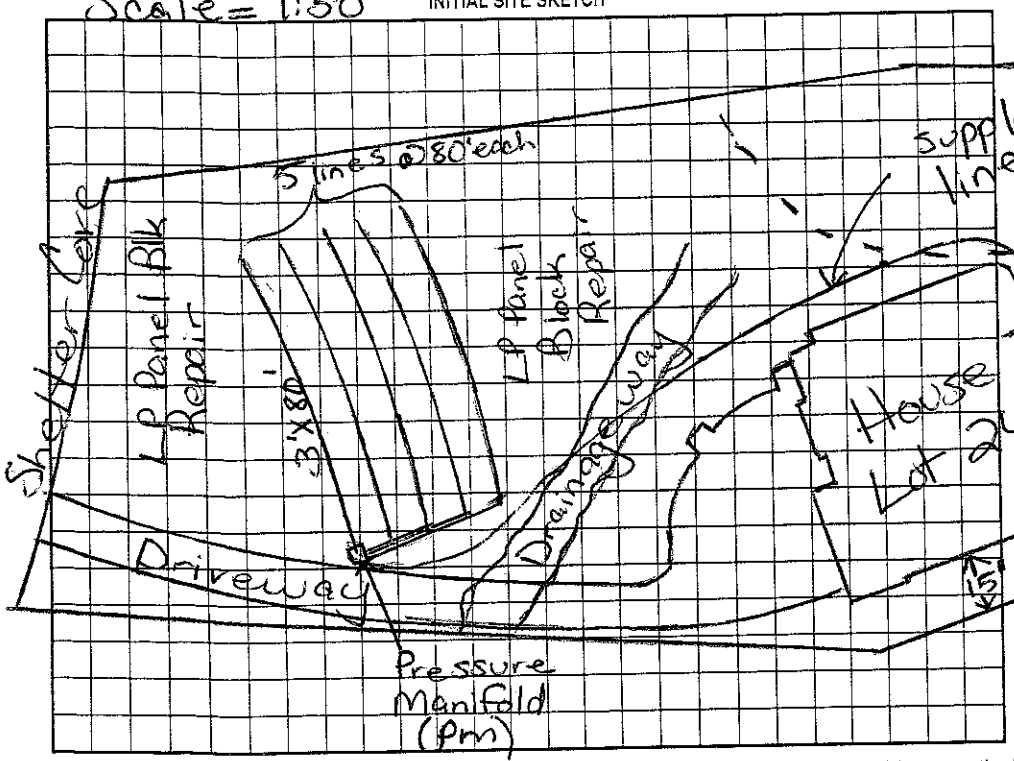

AS BUILT SKETCH

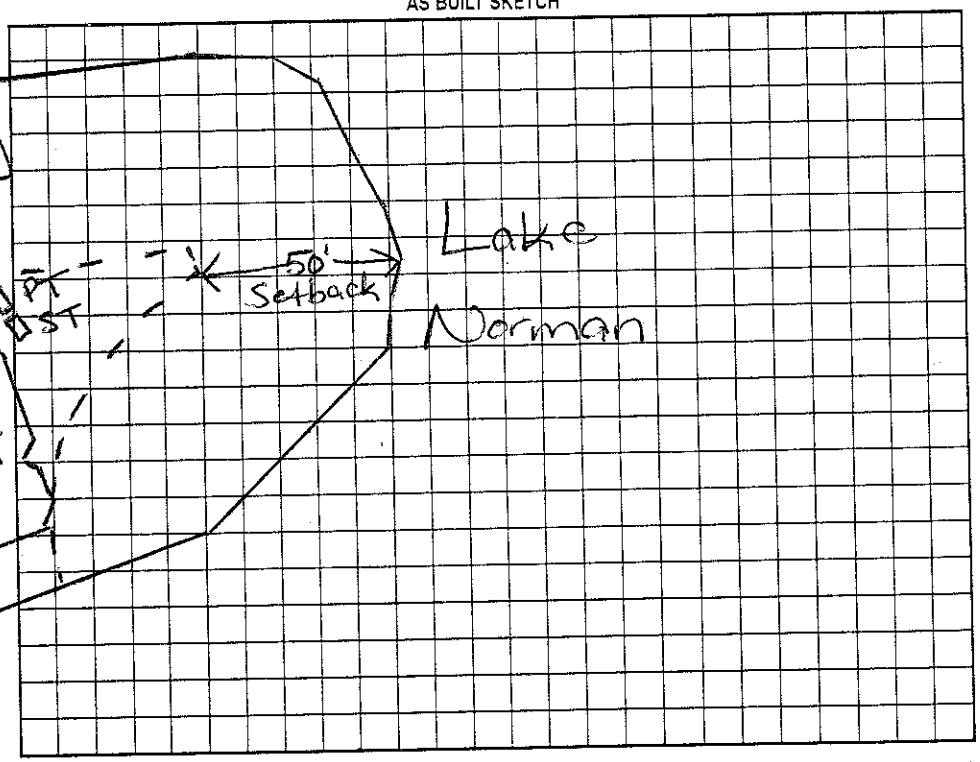

Permit can be suspended or revoked if any false information is supplied toward securing the permit/any unauthorized changes are made to the site/any unauthorized changes are made in the installation of the system. Improvement Permit with plat valid without expiration. Improvement Permit with site plan valid for sixty months. Authorization to Construct is valid for a period equal to that of Improvement Permit – not to exceed sixty months.

Signed: ABJ by [illegible] date

Installed by: E.J Ervin

by: Maria H. Dotson RS date 10/22/02 Operation Permit by: RS date 3/31/04

H. Dotson RS date 10/22/02 Existing System Inspection by: date

HEALTH DEPT. COPY: WHITE OWNER COPY (FINAL): YELLOW OWNER COPY (INITIAL): PINK