IREDELL COUNTY HEALTH DEPARTMENT

Authorization to Construct 2.00

STATESVILLE 704-878-5305 MOORESVILLE 704-664-5281

IMPROVEMENT PERMIT / ~~CERTIFICATE OF COMPLETION~~ / OPERATION PERMIT / EXISTING SYSTEM INSPECTION

PROPERTY DESCRIPTION NO. 22933 DATE 4/3/96 TAX MAP NO. 2N-8-A-6 Watershed: ☒ Yes ☐ No

OWNER OR CONTRACTOR Doug Blew PHONE: Business 4628-61-8247 Home 241-6178

ADDRESS 5332 Lisa Ln. Hickory NC

LOCATION 135 Sienna - Pinnacle Shores → 1st Rt - end of Rd at cul-de-sac

SUBDIVISION Pinnacle Shores BLOCK / SECTION 1 LOT 6 LOT AREA .725 ac SITE CLASS. RS DESIGN FLOW 480 gpd L.T.A.R. .3 gpd/sqft

Septic Tank: 1000 Gallons; STB 794 Date 6/10/97

Pump Tank: _____ Gallons; PT _____ Date _____

Pump Make: _____ Model _____ Serial No. _____

Nitrification Field: No Fields 1 Square Feet 810 Linear Feet 270

No Lines 4 Trench Width 36" Max Trench Bottom Depth 36" Gravel Depth N/A

☒ New System ☐ Repair System Type: I. II. III. IV. V. VI

System Description: Gravity Panels

Repair System Description: Pump Panels

Maintenance Agreement Required: ☐ Yes ☒ No

☒ House/Mod. Home No. Bedrooms 4

☐ Mobile Home No. Bathrooms 3½

☐ Business No. Employees ____

☐ Other ____


☐ Slab ☐ Crawl Space ☐ Basement w/plumbing ☒ Basement wo/plumbing

Water Supply: ☐ Individual ☒ Community ☐ Public

Comments:

Comments: Partial Basement

INITIAL SITE SKETCH

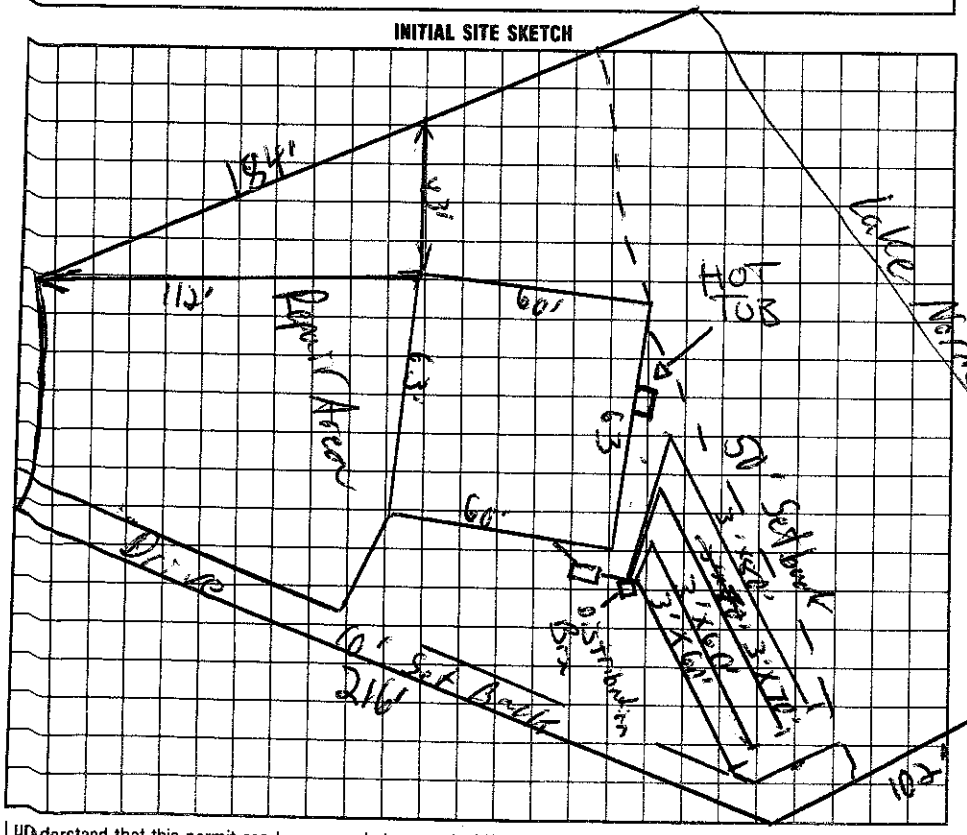

AS BUILT SKETCH

The proposed Hot Tub addition does not appear to impact the existing septic system.

**NOTE: _____

BEN ALDRIDGE R.S.

Date: 1-22-09

ICHD-Environmental Health Division

I understand that this permit can be suspended or revoked if any false information is supplied toward securing the permit/any unauthorized changes are made to the site/any unauthorized changes are made in the installation of the system.

Signed: X D J Blew

Improvement Permit by: C. Brad Teague EHSI date 4/3/96

Existing System Inspection by: C. Brad Teague EHSI date 4/3/96

Installed by: FJ ERVIN

Certificate of Completion by: _____ date _____

Operation Permit by: C. Brad Teague date 8/20/97

HEALTH DEPT. COPY: WHITE INSPECTION COPY (FINAL): GREEN OWNER COPY (FINAL): YELLOW INSPECTION COPY (INITIAL): PINK OWNER COPY (INITIAL): GOLD

Authorization to Construct is Valid for 60 months from date of issue