IREDELL COUNTY HEALTH DEPARTMENT

TATESVILLE 704-8[illegible]-5305 MOORESVILLE 704-664-5281

IMPROVEMENT PERMIT / AUTHORIZATION TO CONSTRUCT / OPERATION PERMIT / EXISTING SYSTEM INSPECTION

PERMIT# 089799 PIN# 4628 62 0562 DATE 7/12/00

OWNER OR CONTRACTOR Janice Patten PHONE Business Home 784-7116

ADDRESS 409 Dewlon Dr. Concord, NC 28025 126 Plantation Dr.

LOCATION Plantation Dr. - 150 W TR Pinnacle Shore Dr. TL Plantation Dr., 2nd lot on (R)

SUBDIVISION Pinnacle Shore BLOCK / SECTION 1 LOT 60 LOT AREA .98 SITE CLASS. PS DESIGN FLOW 360 L.T.A.R. .3

Septic Tank: 1000 Gallons; STB 794 Date 3/23/01

Pump Tank: 1000 Gallons; PT 283 Date 4/9/01

Pump Make: MYERS Model ME-150 Serial No.

Nitrification Field: No Fields 1 Square Feet 1200 Linear Feet 400

No Lines 4@60' Trench Width 36" Max Trench Bottom Depth 36" Gravel Depth 12"

[X] New System [ ] Repair System Type: I, II, (III) IV, V, VI

System Description: PM - Conventional EZ Flow

Repair System Description: Same

Maintenance Agreement Required: [ ] Yes [X] No

[X] House/Mod. Home No. Bedrooms 3

[ ] Mobile Home No. Bathrooms 3

[ ] Business No. Employees

[ ] Other


[ ] Slab [ ] Crawl Space [X] Basement w/plumbing [ ] Basement wo/plumbing

Water Supply: [ ] Individual [ ] Public [X] Community


Comments:/Conditions: 5@60'+3'

Comments:/Conditions:

INITIAL SITE SKETCH

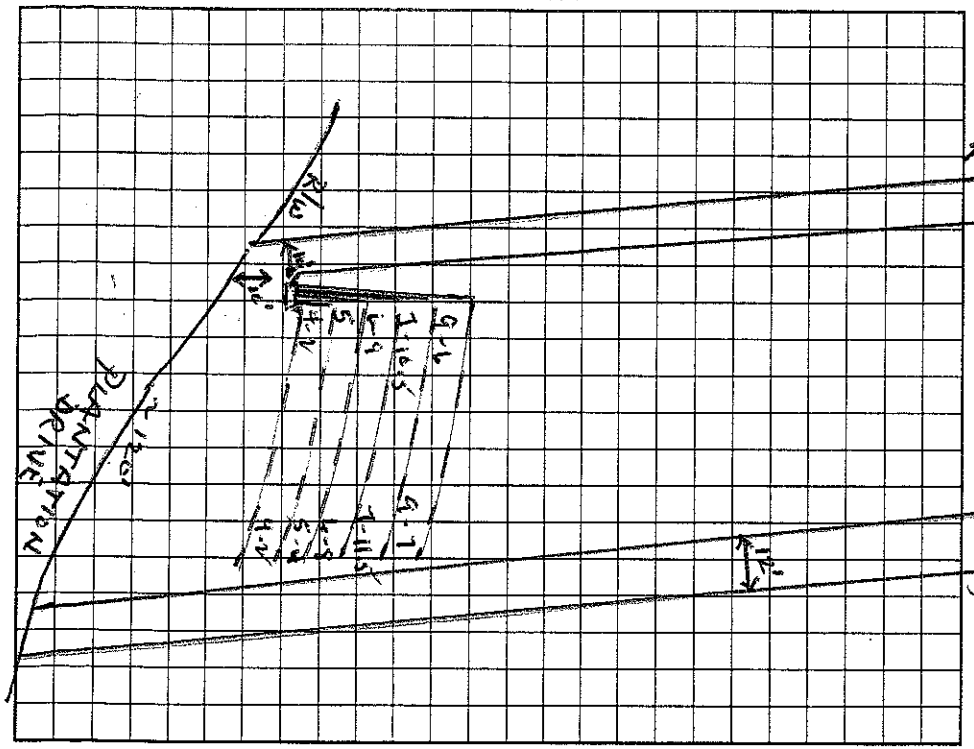

AS BUILT SKETCH

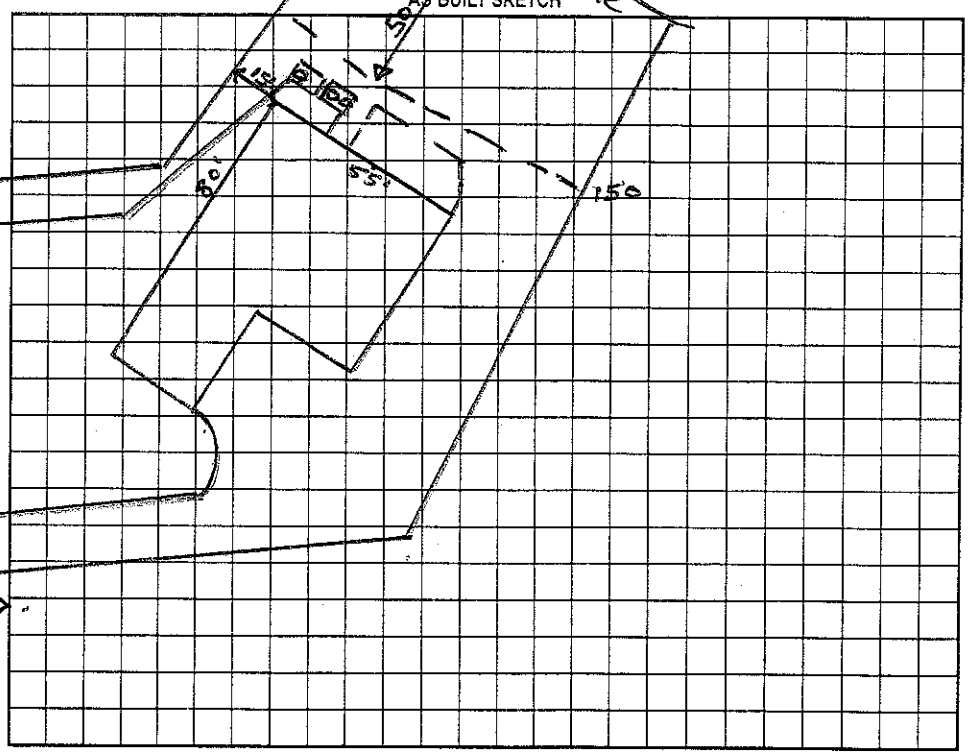

Permit can be suspended or revoked if any false information is supplied toward securing the permit/any unauthorized changes are made to the site/any unauthorized changes are made in the installation of the system. Improvement Permit with plat valid without expiration. Improvement Permit with site plan valid for sixty months. Authorization to Construct is valid for a period equal to that of Improvement Permit – not to exceed sixty months.

Signed: Janice Patten date 7-24-00

Improvement Permit by: Wesley Sparks R.S. date 9/12/00

Authorization to Construct by: Wesley Sparks RS date 7/12/00

Installed by: Rodd Long - Denver

Operation Permit by: Wesley Sparks R.S. date 3/11/02

Existing System Inspection by: date

HEALTH DEPT. COPY: WHITE OWNER COPY (FINAL): YELLOW OWNER COPY (INITIAL): PINK