IREDELL COUNTY HEALTH DEPARTMENT

STATESVILLE 704-878-5305 MOORESVILLE 704-664-5281

IMPROVEMENT PERMIT / CERTIFICATE OF COMPLETION / OPERATION PERMIT / EXISTING SYSTEM INSPECTION

PROPERTY DESCRIPTION NO. 21833 DATE 9/28/95 TAX MAP NO. 2N A20 4628 62 1162 Watershed: ☐ Yes ☒ No

OWNER OR CONTRACTOR Arnold White Homes Inc. PHONE: Business 847-0659 Home

ADDRESS 9420 Henson Dr. Matthews NC 28105

LOCATION Plantation Drive - 150W TR PINNACLE SHORES DR, TL PLANTATION, 2ND lot on (L)

SUBDIVISION Pinnacle Shores BLOCK / SECTION LOT 89 LOT AREA .63Ac SITE CLASS. PS DESIGN FLOW 360 L.T.A.R. .3

Septic Tank: 1000 Gallons; STB 825 RST Date 12-1-95

Pump Tank: 1000 Gallons; PT 47 RST Date 12-1-95

Pump Make: Zoeller Model N137C Serial No. PN 137-0002

Nitrification Field: No Fields 1 Square Feet 1200 Linear Feet ± 300

No Lines 45 Trench Width 36" Max Trench Bottom Depth 32" Gravel Depth N/A

☒ New System ☐ Repair System Type: I, II, (III), IV, V, VI

System Description: Pressure Manifold - Sand Filter

Repair System Description: Same

Maintenance Agreement Required: ☒ Yes ☐ No

☒ House/Mod. Home ☐ Mobile Home ☐ Business ☐ Other

No. Bedrooms 3 No. Bathrooms 2.5 No. Employees


☐ Slab ☒ Crawl Space ☐ Basement w/plumbing ☐ Basement wo/plumbing

Water Supply: ☐ Individual ☒ Community ☐ Public

Comments: ± sand filtration
4 - 1/2" threaded tees on 6" centers off Manifold

Comments: Installed in 5 trenches 60' in length each
Tanks, drainfield, manifold installed 2-13-96 DHH

INITIAL SITE SKETCH

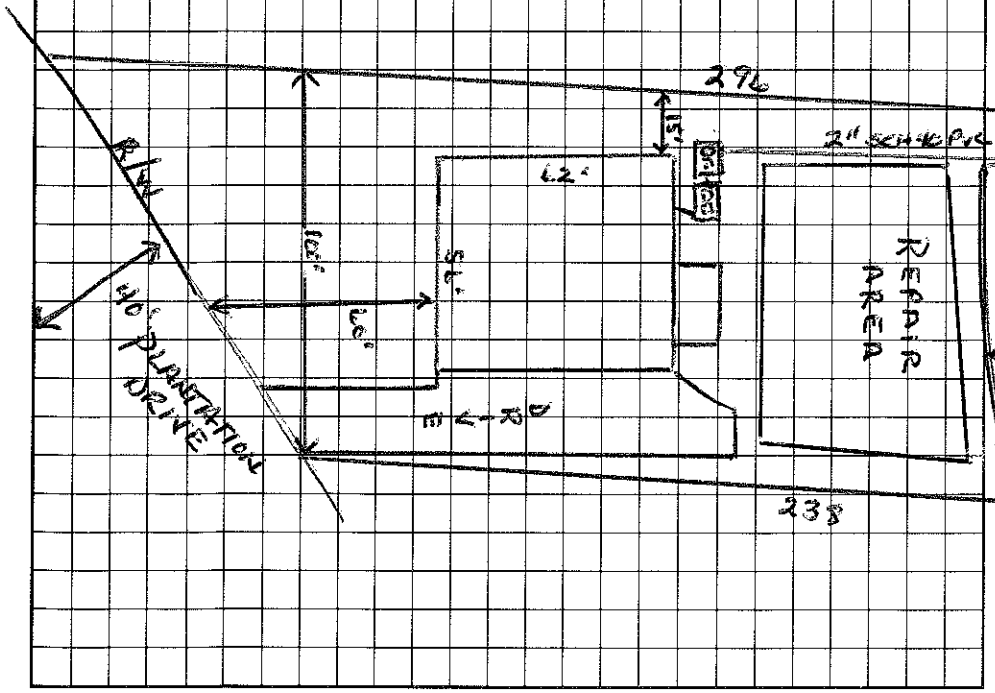

AS BUILT SKETCH

Same as site sketch.

I understand that this permit can be suspended or revoked if any false information is supplied toward securing the permit/any unauthorized changes are made to the site/any unauthorized changes are made in the installation of the system.

Signed: Arnold White 9/25/95

Improvement Permit by: Wesley Sparks RS. date 8/28/95

Existing System Inspection by: date

Installed by: Curt Dunning

Certificate of Completion by: date

Operation Permit by: C. Brady Thomas EHS date 5/6/96

HEALTH DEPT. COPY: WHITE INSPECTION COPY (FINAL): GREEN OWNER COPY (FINAL): YELLOW INSPECTION COPY (INITIAL): PINK OWNER COPY (INITIAL): GOLD