IREDELL COUNTY HEALTH DEPARTMENT

Authorization to Construct (3:00)

STATESVILLE 704-878-5305 MOORESVILLE 704-664-5281

IMPROVEMENT PERMIT / ~~CERTIFICATE OF COMPLETION~~ / OPERATION PERMIT / EXISTING SYSTEM INSPECTION

PROPERTY DESCRIPTION NO. 069847 DATE 10/7/97 TAX MAP NO. 4628 622934 Watershed: X Yes ☐ No

OWNER OR CONTRACTOR James H Spivey PHONE: Business _____ Home 483-2560

ADDRESS 4174 Lakeshore Rd S Denver, NC. 28037

LOCATION 150 W TR Pennock Shore Drive on (L) just past Emerald Point Lane

SUBDIVISION Pennock Shore BLOCK / SECTION 1 LOT 56 LOT AREA .9 AC SITE CLASS. PS DESIGN FLOW 360 L.T.A.R. .3

Septic Tank: 1000 Gallons; STB 794 Date 5/1/99

Pump Tank: 1000 Gallons; PT 27 Date 8/16/99

Pump Make: _____ Model _____ Serial No. _____

Nitrification Field: No Fields 1 Square Feet 600* Linear Feet 200*

No Lines 3 Trench Width 36" Max Trench Bottom Depth 36" Gravel Depth SAND

X New System ☐ Repair System Type: I, II, (III), IV, V, VI

System Description: * 16" PPBS - Pressure MAN.

Repair System Description: SAME

Maintenance Agreement Required: ☐ Yes X No

X House/Mod. Home No. Bedrooms 3

☐ Mobile Home No. Bathrooms 2

☐ Business No. Employees ____

☐ Other _____


☐ Slab ☐ Crawl Space X Basement w/plumbing ☐ Basement wo/plumbing

Water Supply: ☐ Individual X Community ☐ Public


Comments: * 36" WIDE TRENCHES ON 9' CENTERS
3 lines 67' x 3' PREFABRICATED PANEL BLOCKS

Comments:

INITIAL SITE SKETCH

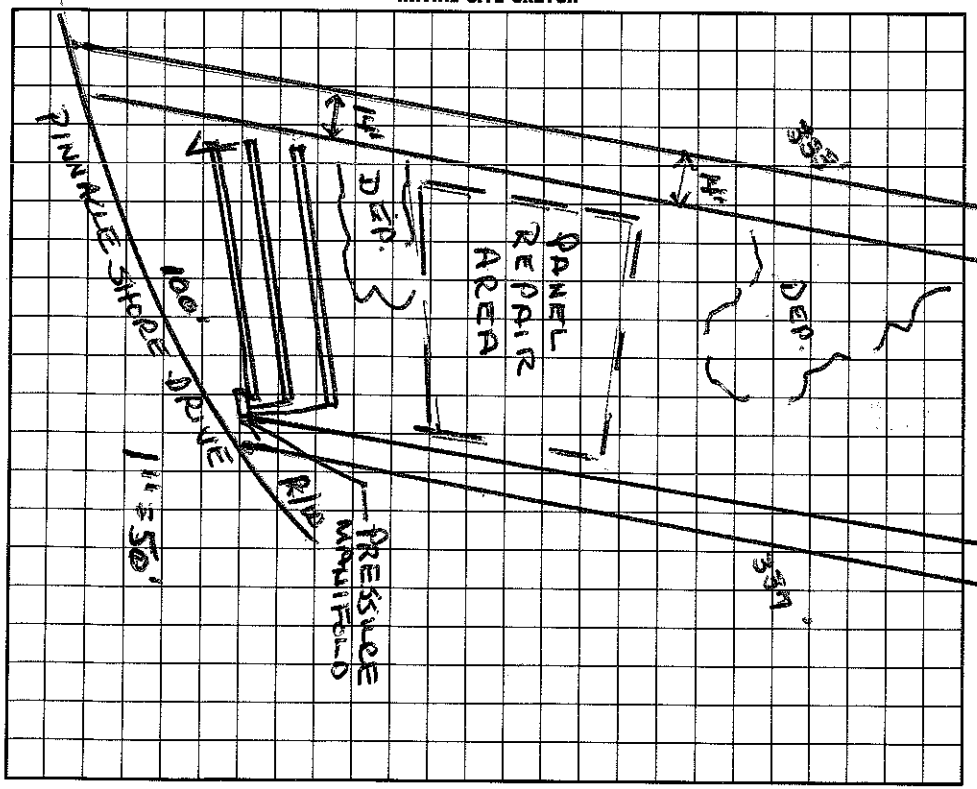

AS BUILT SKETCH

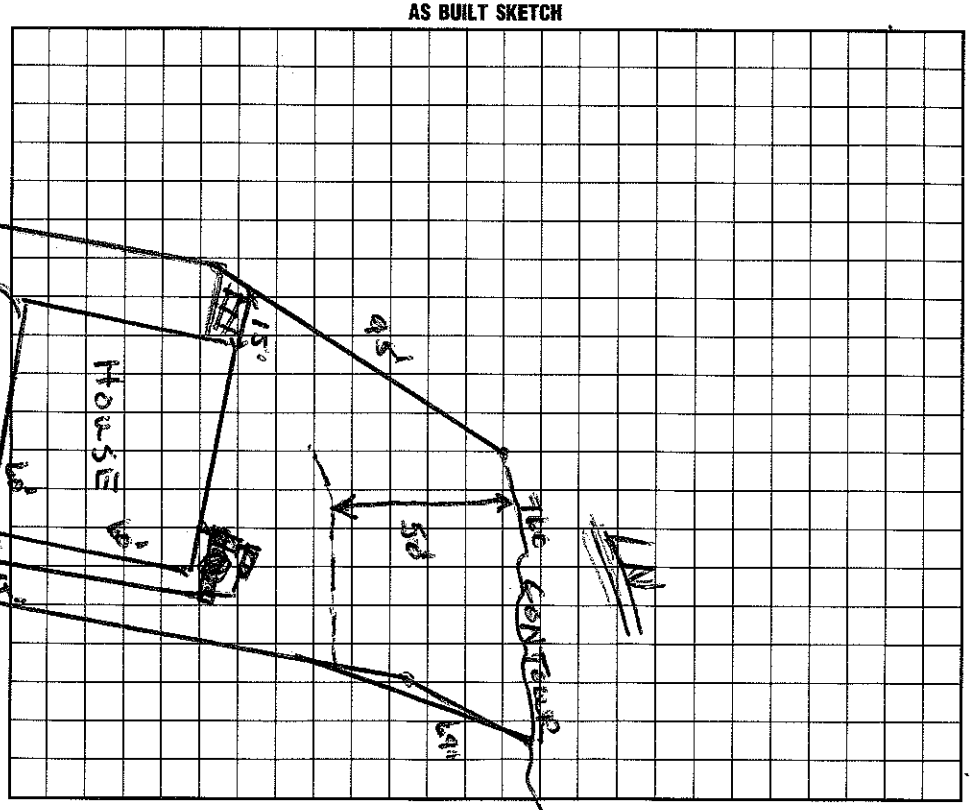

I understand that this permit can be suspended or revoked if any false information is supplied toward securing the permit/any unauthorized changes are made to the site/any unauthorized changes are made in the installation of the system. Improvement Permit is valid for 60 months from date of issuance.

Signed: * James H Spivey

Improvement Permit by: Wesley Sparks R.S. date 10/8/97

Existing System Inspection by: Wesley Sparks R.S. date 10/8/97

Accepted

Installed by: Charles Beatty

Certificate of Completion by: Wesley Sparks R.S. date 10/27/99

Operation Permit by: _____ date _____

HEALTH DEPT. COPY: WHITE INSPECTION COPY (FINAL): GREEN OWNER COPY (FINAL): YELLOW INSPECTION COPY (INITIAL): PINK OWNER COPY (INITIAL): GOLD