IREDELL COUNTY HEALTH DEPARTMENT

STATESVILLE 704-878-5305 MOORESVILLE 704-664-5281

TYPE IV SYSTEM

IMPROVEMENT PERMIT / AUTHORIZATION TO CONSTRUCT / OPERATION PERMIT / EXISTING SYSTEM INSPECTION

PERMIT# 22037 PIN# 2N A 20 Pt of 4628-62-3736 DATE 4/27/98

OWNER OR CONTRACTOR Brian Hall PHONE: Business 309-3253 Home

ADDRESS c/o 817 E Morehead St Suite 10 Charlotte, NC. 28202-2705

LOCATION 150 W TR Pinnacle Shores Dr. on (L) Pent Plantation Dr.

SUBDIVISION Pinnacle Shores BLOCK / SECTION 3 LOT 58 LOT AREA ~.9Ac SITE CLASS. PS DESIGN FLOW 480 L.T.A.R. .3

Septic Tank: 1000 Gallons; STB 794 Date 12/5/98
Pump Tank: 1000 Gallons; PT 27 Date 12/18/98
Pump Make: MYERS Model ME-100 Serial No.
Nitrification Field: No Fields 1 Square Feet *840 Linear Feet *270
No Lines 4 Trench Width 36" Max Trench Bottom Depth 36" Gravel Depth SAND

☒ New System ☐ Repair System Type: I, II, III, IV, V, VI
System Description: 16" PPBS - Pressure Dosed
Repair System Description: SAME
Maintenance Agreement Required: ☐ Yes ☒ No


☒ House/Mod. Home No. Bedrooms 4
☐ Mobile Home No. Bathrooms 3.5
☐ Business No. Employees
☐ Other
☐ Slab ☐ Crawl Space ☒ Basement w/plumbing ☐ Basement wo/plumbing

Water Supply:
☐ Individual
☐ Public
☒ Community


Comments:/Conditions: * PPBS 16" - Pressure Distribution
*50% lineal footage reduction.

Comments:/Conditions:

INITIAL SITE SKETCH

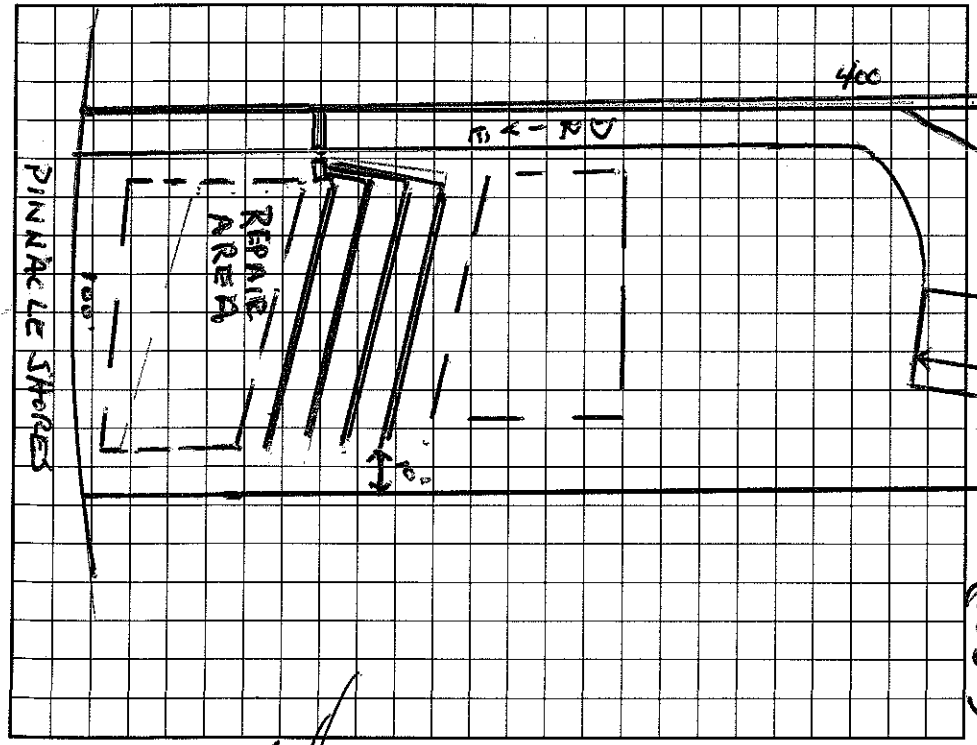

AS BUILT SKETCH

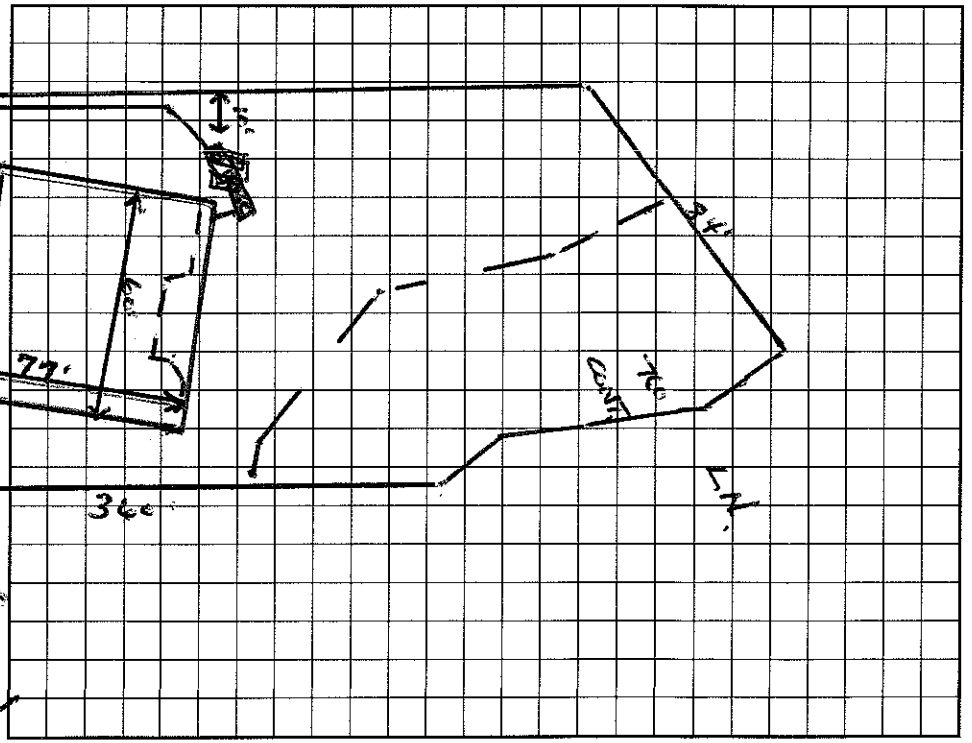

I understand that this permit can be suspended or revoked if any false information is supplied toward securing the permit/any unauthorized changes are made to the site/any unauthorized changes are made in the installation of the system. Improvement Permit with plat valid without expiration. Improvement Permit with site plan valid for sixty months. Authorization to Construct is valid for a period equal to that of Improvement Permit – not to exceed sixty months.

Signed: * date 5/27/98 Installed by: R+H Inc.

Improvement Permit by: Wesley Sparks R.S. date 4/27/98 Operation Permit by: Wesley Sparks R.S. date 3/25/99

Authorization to Construct by: Wesley Sparks R.S. date 4/27/98 Existing System Inspection by: date

HEALTH DEPT. COPY: WHITE INSPECTION COPY (FINAL): GREEN OWNER COPY (FINAL): YELLOW INSPECTION COPY (INITIAL): PINK OWNER COPY (INITIAL): GOLD