IREDELL COUNTY HEALTH DEPARTMENT

Authorization Construct

STATESVILLE 704-878-5305 MOORESVILLE 704-664-5281

IMPROVEMENT PERMIT / ~~CERTIFICATE OF COMPLETION~~ / OPERATION PERMIT / EXISTING SYSTEM INSPECTION

PROPERTY DESCRIPTION NO. 22418 DATE 1/6/96 TAX MAP NO. 2N 8 A 21 Watershed: X Yes ☐ No

OWNER OR CONTRACTOR Julia Shelton / Mark Shelton PHONE: Business Home 542-1691

ADDRESS 7741-101 Hubbard Farm Dr. Charlotte, N.C. 28720 4628-62-4046

LOCATION Pinnacle Shores (R) off 150W to to 3rd (R) on (R) corner

SUBDIVISION Pinnacle Shores BLOCK / SECTION 1 LOT 21 LOT AREA .7 SITE CLASS. PS DESIGN FLOW 360 L.T.A.R. .35

Septic Tank: 1000 Gallons; STB 786 Date 5/26/96

Pump Tank: Gallons; PT Date

Pump Make: Model Serial No.

Nitrification Field: No Fields 1 Square Feet 1028 Linear Feet ~~*250~~ (342)

No Lines Trench Width 36" Max Trench Bottom Depth 32" Gravel Depth 6" SAND

☐ New System ☐ Repair System Type: I, II, III, IV, V, VI

System Description: Gravity w/ Infiltrator

Repair System Description: Drum

Maintenance Agreement Required: ☐ Yes X No

X House/Mod. Home No. Bedrooms 3

☐ Mobile Home No. Bathrooms 3

☐ Business No. Employees

☐ Other


☐ Slab X Crawl Space ☐ Basement w/plumbing ☐ Basement wo/plumbing

Water Supply: ☐ Individual X Community ☐ Public


Comments: ~~*25%~~ reduction for infiltrator use
Sand backfill to top of louver on panels

Comments:

INITIAL SITE SKETCH

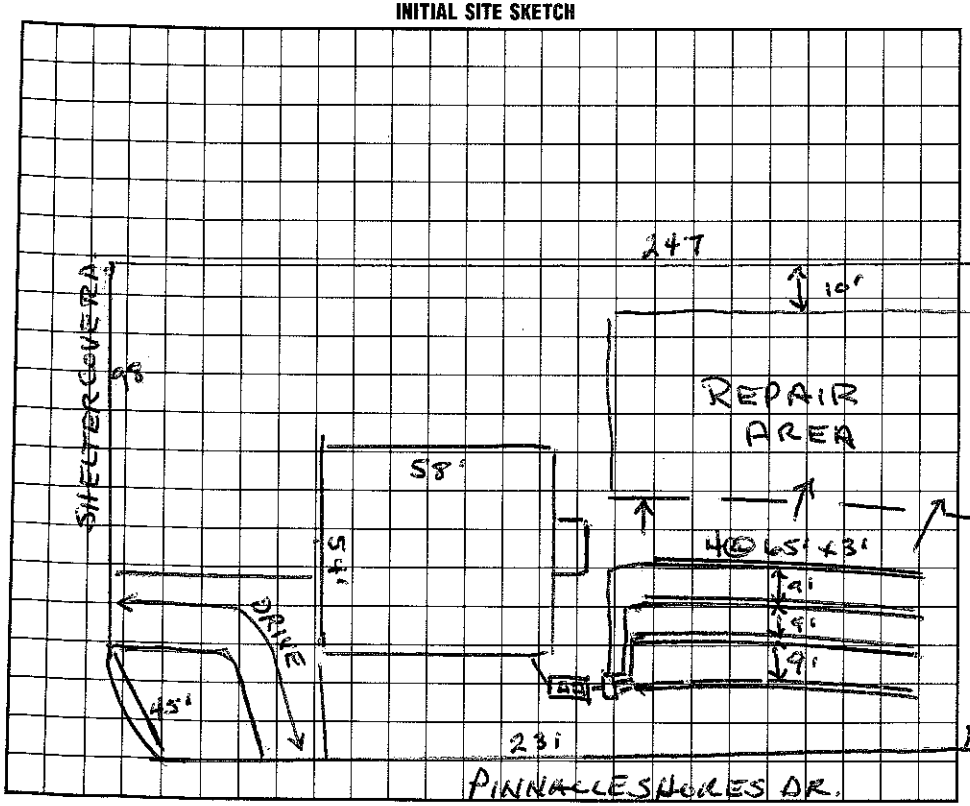

AS BUILT SKETCH

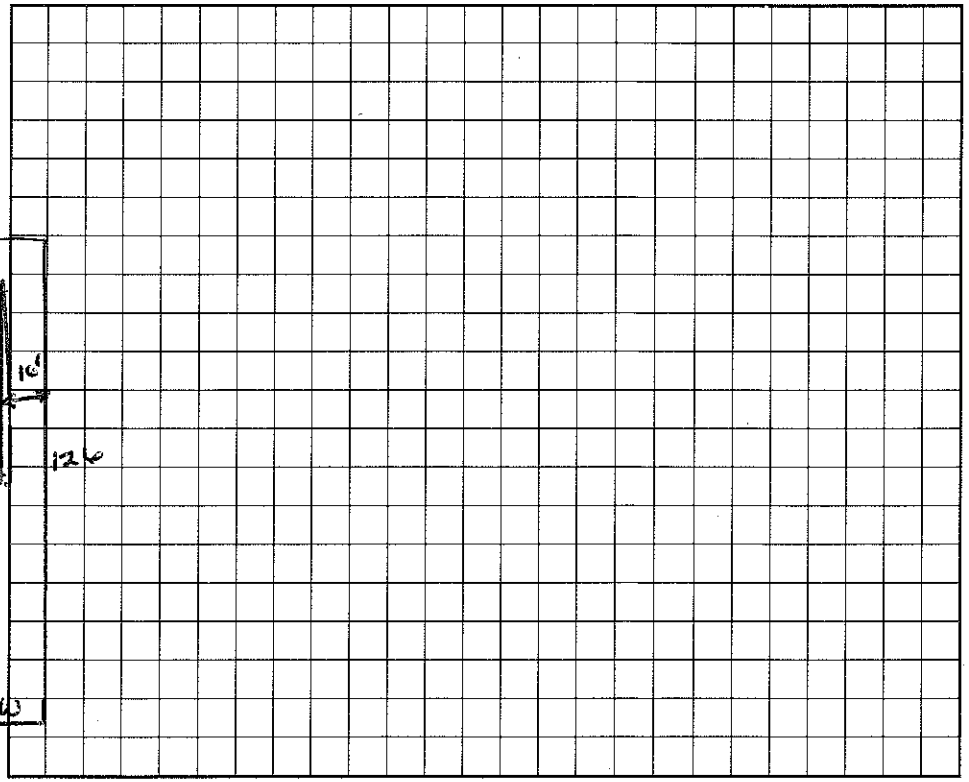

I understand that this permit can be suspended or revoked if any false information is supplied toward securing the permit/any unauthorized changes are made to the site/any unauthorized changes are made in the installation of the system.

Signed: X

Improvement Permit by: Wesley Sparks RS. date 1/6/96

Existing system inspection by: Wesley Sparks RS. date 1/6/96

Installed by: Dennis Hoyle

Certificate of Completion by: date

Operation Permit by: Wesley Sparks RS. date 9/12/96

Authorization Construct

HEALTH DEPT. COPY: WHITE INSPECTION COPY (FINAL): GREEN OWNER COPY (FINAL): YELLOW INSPECTION COPY (INITIAL): PINK OWNER COPY (INITIAL): GOLD