IREDELL COUNTY HEALTH DEPARTMENT

STATESVILLE 704-878-5305 MOORESVILLE 704-664-5281

IMPROVEMENT PERMIT / AUTHORIZATION TO CONSTRUCT / OPERATION PERMIT / EXISTING SYSTEM INSPECTION

PERMIT# 21312 PIN# pt of 2NA20 4628-62-6158 DATE 5/11/98

OWNER OR CONTRACTOR MECKLENBURG HOMEWORKS, INC PHONE: Business _____ Home 896-0382

ADDRESS 7523 MARINER COVE DR. CORNELIUS NC 28031

LOCATION 150 W - TR PINNACLE SHORES DR. - TR SHELTER COVE LN. - 2nd Lot on LT.

SUBDIVISION PINNACLE SHORES BLOCK / SECTION I LOT 31 LOT AREA — SITE CLASS. RS DESIGN FLOW 480 L.T.A.R. .3

Septic Tank: 1000 Gallons; STB 744 Date 7/1/96

Pump Tank: _____ Gallons; PT _____ Date _____

Pump Make: _____ Model _____ Serial No. _____

Nitrification Field: No Fields 1 Square Feet 533 Linear Feet 270

No Lines 6 @ 45' Trench Width 24" Max Trench Bottom Depth 36" Gravel Depth N/A

☑ New System ☐ Repair System Type: I, II, III, IV, V, VI

System Description: GRAVITY @ PANEL

Repair System Description: PUMP PANEL

Maintenance Agreement Required: ☐ Yes ☑ No

☑ House/Mod. Home No. Bedrooms 4

☐ Mobile Home No. Bathrooms 4

☐ Business No. Employees _____

☐ Other _____


☐ Slab ☐ Crawl Space ☑ Basement w/plumbing ☐ Basement wo/plumbing

Water Supply: ☐ Individual ☐ Public ☑ Community

Comments:/Conditions: FLOW DIVIDER & 2 DIST BOXES

Comments:/Conditions: 9/29/98 - Checked 3 left side lines - AWS

INITIAL SITE SKETCH 1" = 50'

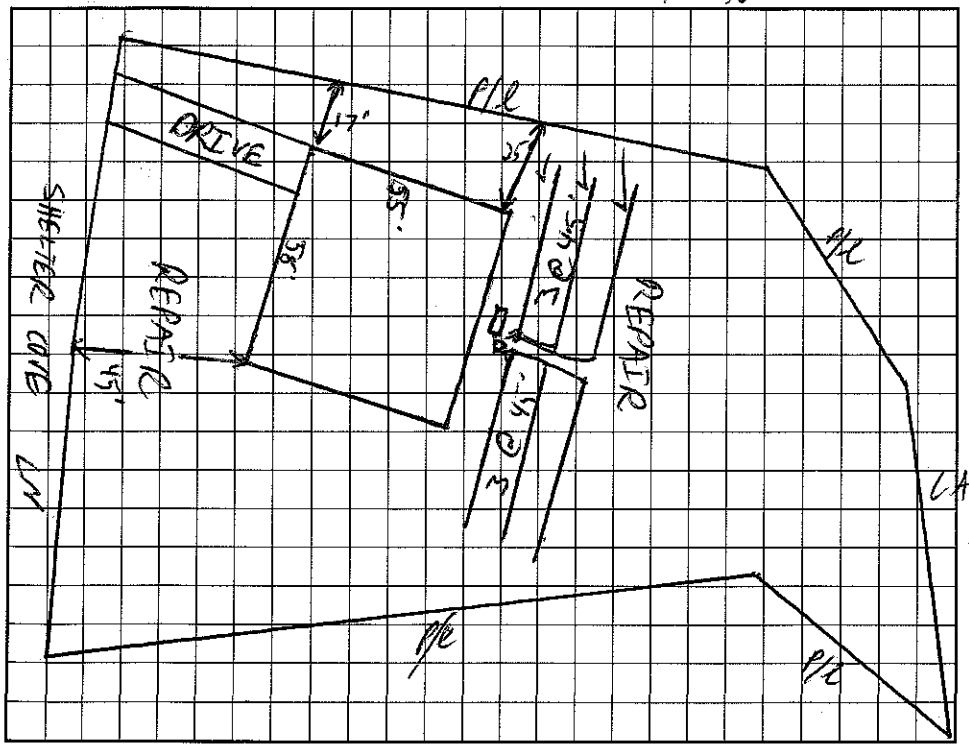

AS BUILT SKETCH

I understand that this permit can be suspended or revoked if any false information is supplied toward securing the permit/any unauthorized changes are made to the site/any unauthorized changes are made in the installation of the system. Improvement Permit with plat valid without expiration. Improvement Permit with site plan valid for sixty months. Authorization to Construct is valid for a period equal to that of Improvement Permit – not to exceed sixty months.

Signed: Brittan Davis Mecklenburg Homeworks date 5/11/98 Installed by: Dobinson Const.

Improvement Permit by: C. Ray Green date 5/11/98 Operation Permit by: C. Ray Green date 10/1/98

Authorization to Construct by: C. Ray Green date 5/11/98 Existing System Inspection by: _____ date _____

HEALTH DEPT. COPY: WHITE INSPECTION COPY (FINAL): GREEN OWNER COPY (FINAL): YELLOW INSPECTION COPY (INITIAL): PINK OWNER COPY (INITIAL): GOLD