IREDELL COUNTY HEALTH DEPARTMENT

STATESVILLE 704-878-5305 MOORESVILLE 704-664-5281

IMPROVEMENT PERMIT / AUTHORIZATION TO CONSTRUCT / OPERATION PERMIT / EXISTING SYSTEM INSPECTION

PERMIT # 171669 PIN # 4628626420 DATE 6-25-2012

OWNER or APPLICANT Douglas Locke PHONE: Business 704 746-3578 Home: 704 746 3647

OWNER or APPLICANT ADDRESS 190 Pinnacle Shores Dr.

LOCATION / DIRECTIONS Hwy 150 W TR Pinnacle Shores Dr on right just past Shelter Cove Ln.

SUBDIVISION Pinnacle Shores BLOCK / SECTION LOT # 33 LOT AREA .71 Ac DESIGN FLOW 480gpd L.T.A.R. .3

Septic Tank 1000 Gallons: STB Date

Pump Tank 1000 Gallons: PT Date

Pump Make Model Serial #

Nitrification Field No Fields 1 No Lines 4 Linear Feet 266'

Trench Width 24" Max. Trench Bottom Depth 36" Gravel Depth N/A

☐ New System ☐ Repair ☐ Expansion System Type I II III IV V VI

System Description: Existing LP-Panel Block

Repair System Description: Same

Maintenance Agreement Required ☒ YES ☐ NO

☐ GRAVITY ☒ PRESSURE

☒ Residence No. Bedrooms 4

☐ Business No. Persons

☐ Other No. Employees

☐ Slab ☐ Crawl Space


☒ Basement w/plumbing ☐ Basement w/o plumbing

Water Supply: ☐ Private ☐ Public ☒ Community


Comments / Conditions: Existing Septic System appears to be functioning okay at time of inspection.

Comments / Conditions: Upper deck for 2nd Floor will be over existing tanks however footers will be 5ft from both tanks. There will be access to tanks for maintenance

INITIAL SITE SKETCH

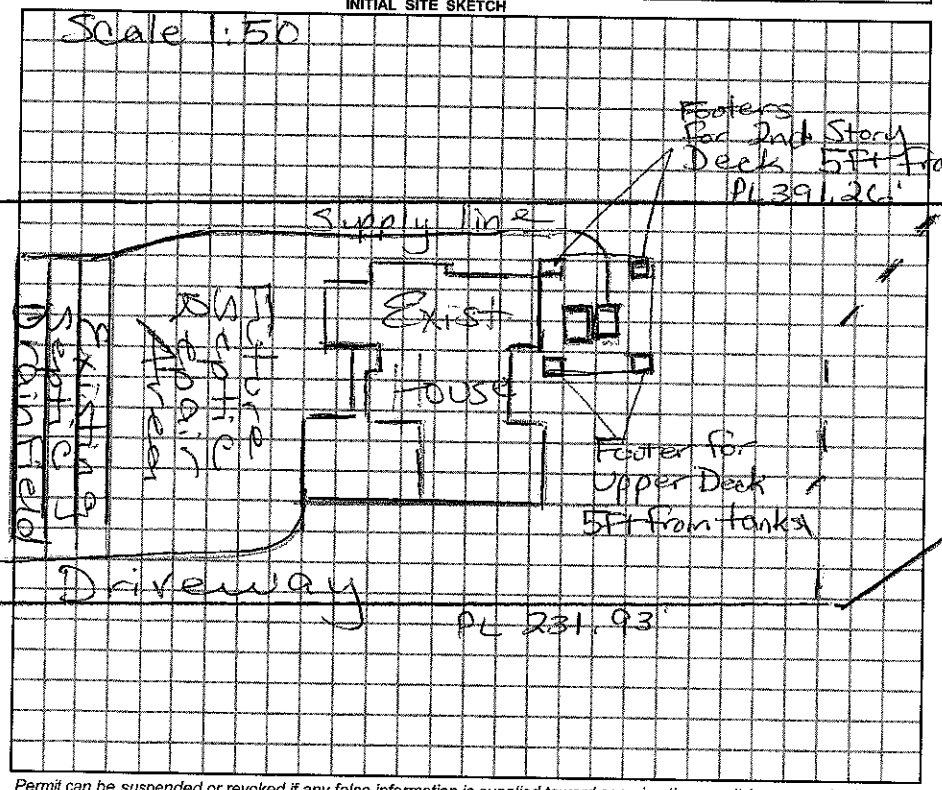

AS BUILT SKETCH

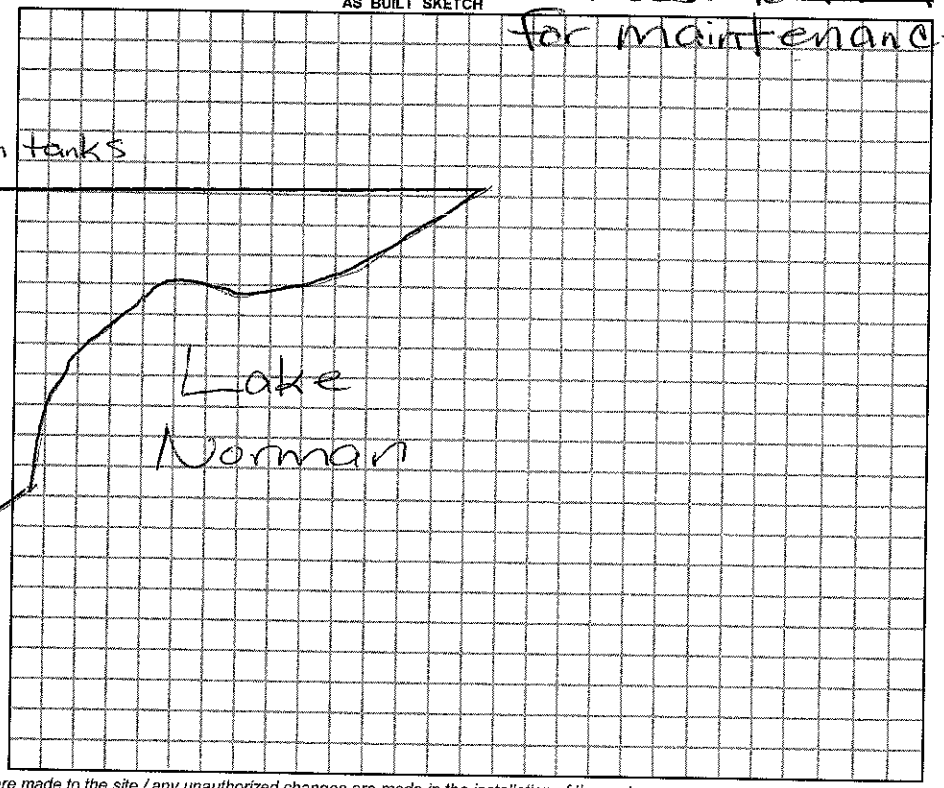

Permit can be suspended or revoked if any false information is supplied toward securing the permit / any unauthorized changes are made to the site / any unauthorized changes are made in the installation of the system.

☐ IMPROVEMENT PERMIT w / plot valid without expiration ☐ IMPROVEMENT PERMIT w / site plan valid for 60 mos. ☐ AUTHORIZATION TO CONSTRUCT valid for period equal to IMPROVEMENT PERMIT-not to exceed 60 mo.

Owner / Applicant Signature: X D.K. Locke Date 4/28/12

Improvement Permit by: Date

Authorization to Construct by: Date

YOU SHOULD CONTACT A LOCATOR SERVICE PRIOR TO ANY EXCAVATION.

Installed by: R&H 6/25/02

Operation Permit by: Date

Existing System Inspected by: Date: 6/25/12

WHITE COPY Environmental Health YELLOW COPY (Final) Owner / Applicant PINK COPY (Initial) Owner / Applicant