IREDELL COUNTY HEALTH DEPARTMENT

STATESVILLE 704-878-5305 MOORESVILLE 704-664-5281

IMPROVEMENT PERMIT / AUTHORIZATION TO CONSTRUCT / OPERATION PERMIT / EXISTING SYSTEM INSPECTION

PERMIT# 074755 PIN# 4628627448 DATE 7/27/98

OWNER OR CONTRACTOR DAVID McKNIGHT PHONE: Business Home

ADDRESS 10729 LEVERS HALL HUNTERSVILLE NC 28078

LOCATION 150 W-TR PINNACLE SHORES - OR RT PAST SHELTER COVE

SUBDIVISION PINNACLE SHORES BLOCK / SECTION I LOT 3F LOT AREA 1.16AC SITE CLASS. PS DESIGN FLOW 480 L.T.A.R. .33

Septic Tank: 1000 Gallons; STB 794 Date 5/6/99
Pump Tank: 1000 Gallons; PT 29 Date 3/8/99
Pump Make: GOULDS Model WE07J12H Serial No. 3/29/[illegible]00
Nitrification Field: No Fields 1 Square Feet 1200 Linear Feet 400
No Lines ~~[illegible]~~ Trench Width 36" Max Trench Bottom Depth 36" Gravel Depth N/A

☑ New System ☐ Repair System Type: I, II, III, IV, V, VI
System Description: PUMP CHAMBERS OR HDS
Repair System Description: PUMP PANEL
Maintenance Agreement Required: ☐ Yes ☑ No

☑ House/Mod. Home No. Bedrooms 4
☐ Mobile Home No. Bathrooms 4
☐ Business No. Employees
☐ Other


☐ Slab ☑ Crawl Space ☑ Basement w/plumbing ☐ Basement wo/plumbing

Water Supply: ☐ Individual ☐ Public ☑ Community


Comments:/Conditions: 5@60'x3' Installed.

Comments:/Conditions:

INITIAL SITE SKETCH 1"=60'

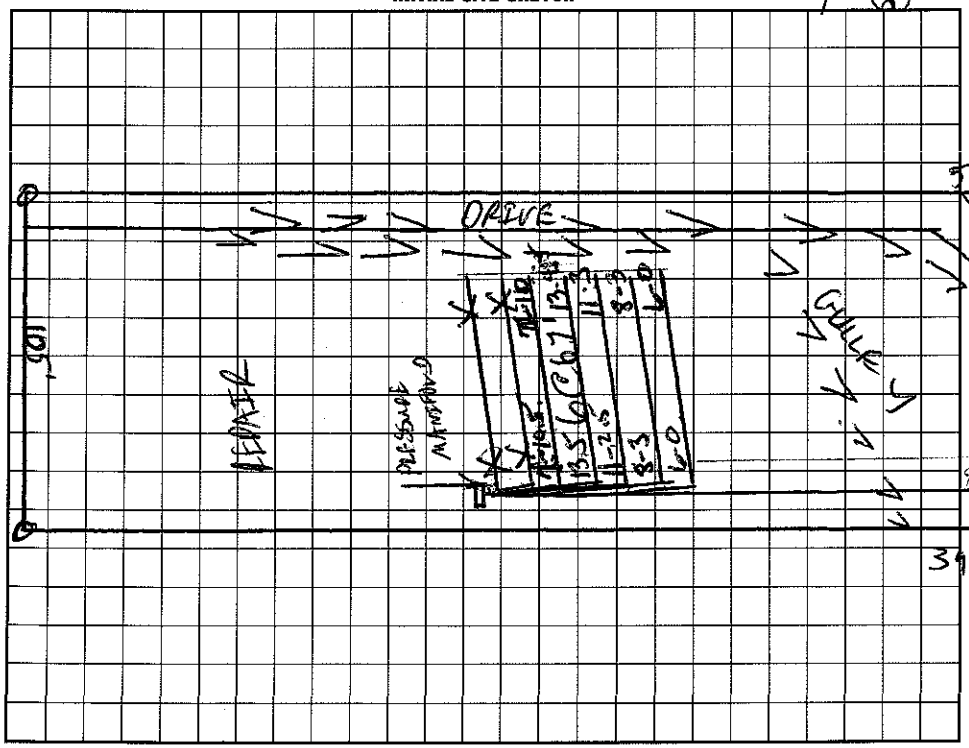

AS BUILT SKETCH

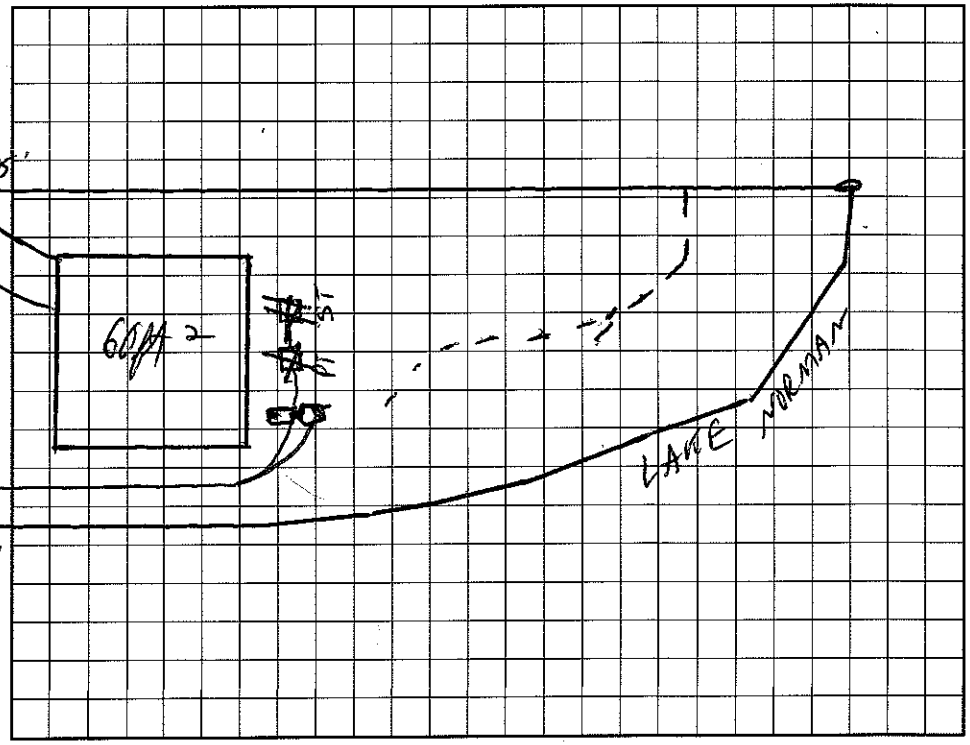

I understand that this permit can be suspended or revoked if any false information is supplied toward securing the permit/any unauthorized changes are made to the site/any unauthorized changes are made in the installation of the system. Improvement Permit with plat valid without expiration. Improvement Permit with site plan valid for sixty months. Authorization to Construct is valid for a period equal to that of Improvement Permit – not to exceed sixty months.

Signed: [signature] date 7/28/98 Installed by: F J Erwin

Improvement Permit by: C. Thomas RS date 7/27/98 Operation Permit by: Wesley Sanders date 10/25/99

Authorization to Construct by: C Thomas RS date 7/27/98 Existing System Inspection by: date

HEALTH DEPT. COPY: WHITE INSPECTION COPY (FINAL): GREEN OWNER COPY (FINAL): YELLOW INSPECTION COPY (INITIAL): PINK OWNER COPY (INITIAL): GOLD