IREDELL COUNTY HEALTH DEPARTMENT

STATESVILLE 704-878-5305 (3:00) MOORESVILLE 704-664-5281

IMPROVEMENT PERMIT / CERTIFICATE OF COMPLETION / OPERATION PERMIT / EXISTING SYSTEM INSPECTION

PROPERTY DESCRIPTION NO. 21950 DATE 9/23/95 TAX MAP NO. Pt of 2N A 20 Watershed: [X] Yes [ ] No

OWNER OR CONTRACTOR Kenneth Kotowicz PHONE: Business 892-6556 (Heidi) Home 4628 62 7598

ADDRESS 19300 Statesville Rd. Davidson, NC.

LOCATION 150 W TR Pinnacle Shores Rd, pass 3 roads to (R), 4th lot on (R)

SUBDIVISION Pinnacle Shores BLOCK / SECTION ____ LOT 35 LOT AREA ~1.6 AC SITE CLASS. PS DESIGN FLOW 480 L.T.A.R. .35

Septic Tank: 1000 Gallons; STB 794 Date 6/18/96

Pump Tank: 1000 Gallons; PT 27 Date 8/10/96

Pump Make: MYERS Model ____ Serial No. E150521

Nitrification Field: No Fields 1 Square Feet 1371 Linear Feet *342

No Lines 4 Trench Width 36" Max Trench Bottom Depth 36" Gravel Depth N/A

[X] New System [ ] Repair System Type: I, II, (III) IV, V, VI

System Description: PRESSUREMAN - INFILTRATOR

Repair System Description: SAME

Maintenance Agreement Required: [X] Yes [ ] No

[X] House/Mod. Home No. Bedrooms 4

[ ] Mobile Home No. Bathrooms 3

[ ] Business No. Employees ____

[ ] Other ____


[ ] Slab [ ] Crawl Space [X] Basement w/plumbing [ ] Basement wo/plumbing

Water Supply: [ ] Individual [X] Community [ ] Public


Comments: * 25% reduction for use of Infiltrator

Comments: LINES, TANKS CHECKED 9/13/96

INITIAL SITE SKETCH

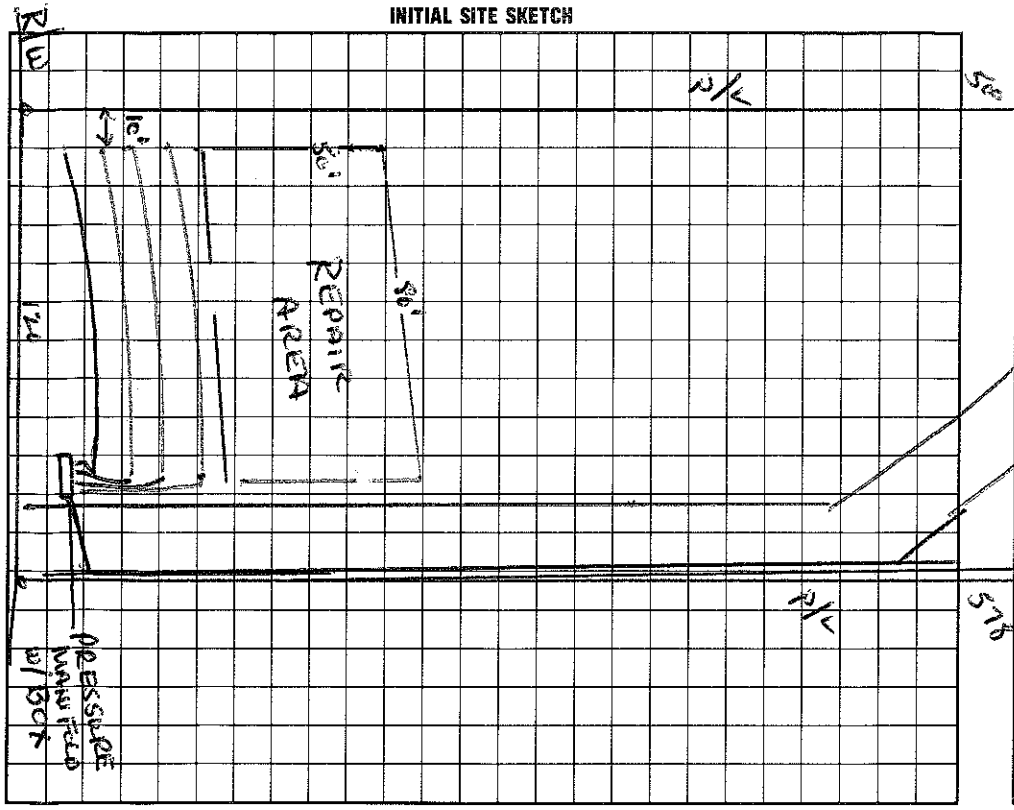

AS BUILT SKETCH

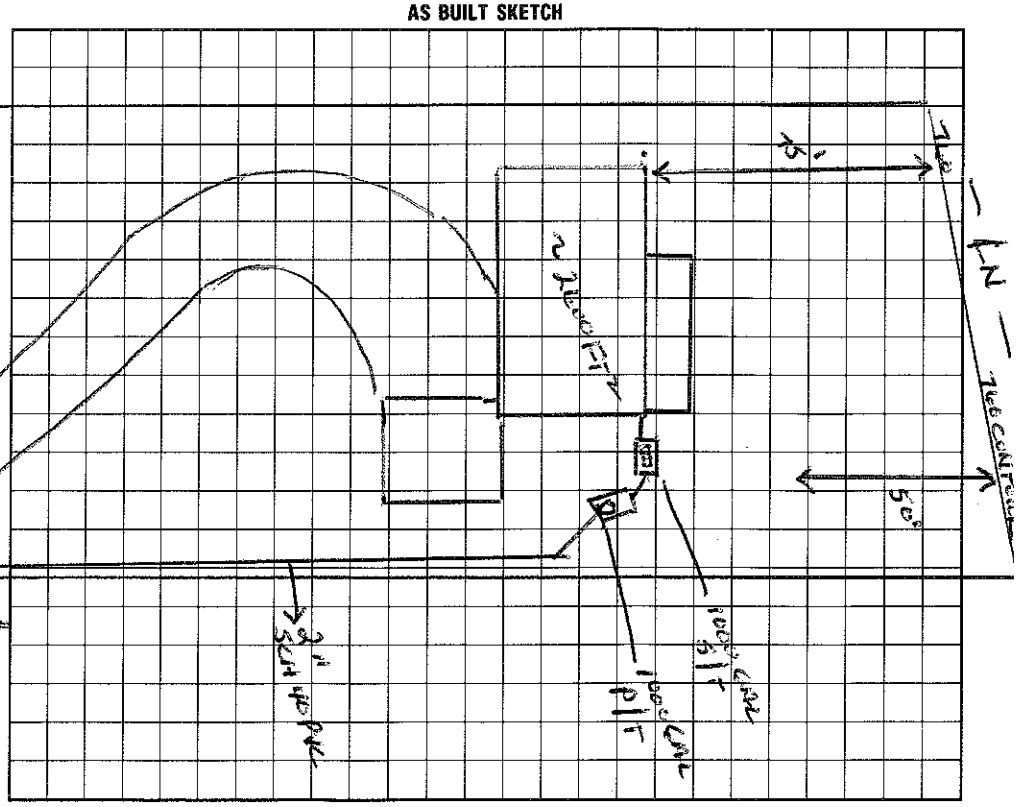

PINNACLE SHORE DR.

I understand that this permit can be suspended or revoked if any false information is supplied toward securing the permit/any unauthorized changes are made to the site/any unauthorized changes are made in the installation of the system.

Signed: Jo Ryan, Agent

Improvement Permit by: Wesley Sparks RS. date 9/23/95

Existing System Inspection by: ____ date ____

Installed by: KIRT DUNNING

Certificate of Completion by: ____ date ____

Operation Permit by: C. Paul Freeman EHS date 9/27/96

HEALTH DEPT. COPY: WHITE INSPECTION COPY (FINAL): GREEN OWNER COPY (FINAL): YELLOW INSPECTION COPY (INITIAL): PINK OWNER COPY (INITIAL): GOLD