IREDELL COUNTY HEALTH DEPARTMENT

STATESVILLE 704-878-5305 MOORESVILLE 704-664-5281

IMPROVEMENT PERMIT / CERTIFICATE OF COMPLETION / OPERATION PERMIT / EXISTING SYSTEM INSPECT.

PROPERTY DESCRIPTION NO. 21313 DATE Aug 3, '95 TAX MAP NO. part of 2VA20 4628 62 7731 Watershed: ☑ Yes ☐ No

OWNER OR CONTRACTOR Crescent Resources Inc (Doug McBride) PHONE: Business 4578-3857 Home WS4

ADDRESS PO Box 1003, Charlotte

LOCATION 150± Ft Pinnacle Shores Drive on Right just before Emerald Point Lane

SUBDIVISION Pinnacle Shores BLOCK / SECTION I LOT 36 LOT AREA SITE CLASS. P5 per 1956 DESIGN FLOW 480 gpd L.T.A.R. .3

Septic Tank: 1000 Gallons; STB 794 Date 3/6/96

Pump Tank: 1000 Gallons; PT 27 Date 6/5/96

Pump Make: LIBERTY Model LE61A Serial No.

Nitrification Field: No Fields 1 Square Feet Linear Feet 270

No Lines 2+2 Trench Width 24" Max Trench Bottom Depth ≈30" Gravel Depth N/A

☑ New System ☐ Repair System Type: I, II, III, IV, V, VI

System Description: LP PBPS

Repair System Description: LP PBPS

Maintenance Agreement Required: ☑ Yes ☐ No

☑ House/Mod. Home No. Bedrooms 4

☐ Mobile Home No. Bathrooms 4

☐ Business No. Employees

☐ Other


☐ Slab ☐ Crawl Space ☑ Basement w/plumbing ☐ Basement wo/plumbing

Water Supply: ☐ Individual ☑ Community ☐ Public


Comments: Extremely complex topography over majority of site

Comments: DEVELOPER PERMIT Feb 5, '96 OK to change driveway to left side boundary. May need to sleeve supply line or change direction to right side. If equal length laterals are used, distribution can be 4, ½" tees - system type now 3 maintenance agreement not required

INITIAL SITE SKETCH 1"=50'

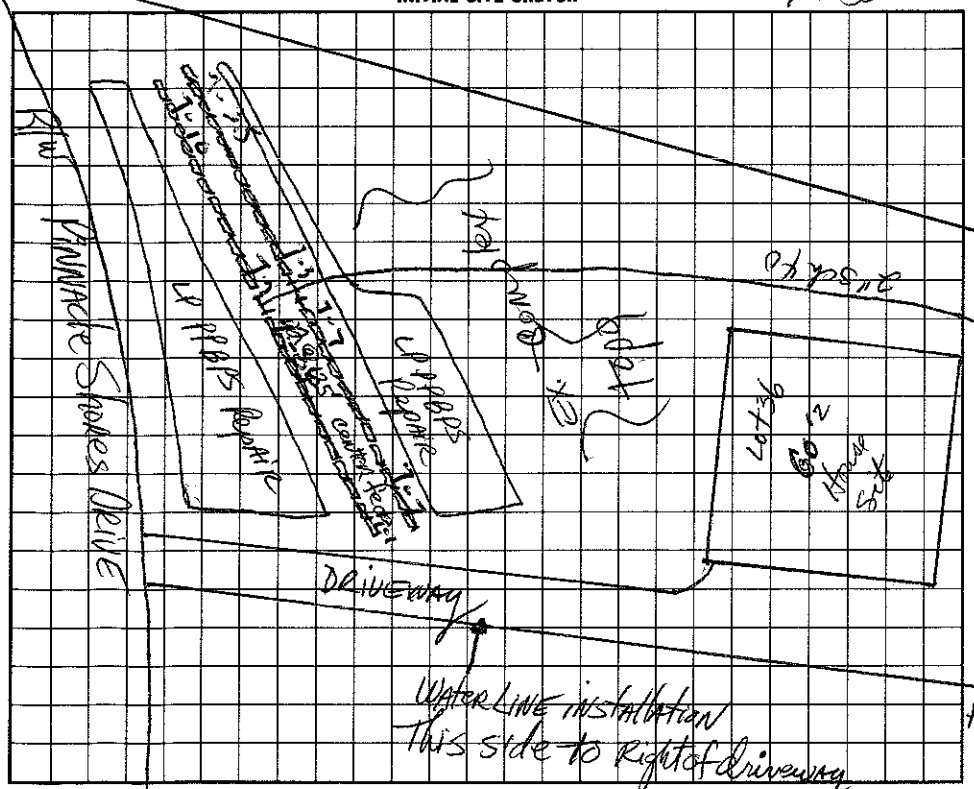

AS BUILT SKETCH 4" pressure manifold - Center fed

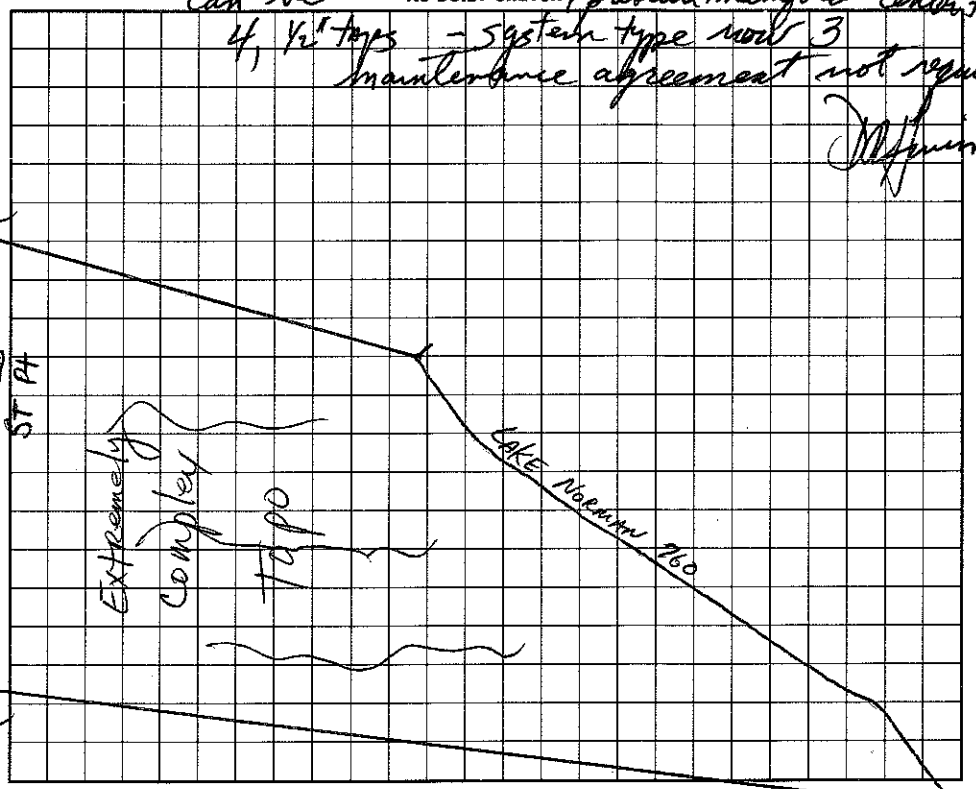

I understand that this permit can be suspended or revoked if any false information is supplied toward securing the permit/any unauthorized changes are made to the site/any unauthorized changes are made in the installation of the system.

Signed: [signature]

Improvement Permit by: [signature] RS date 8-3-95

Authorization to conduct Existing System Inspection by: [signature] RS date 2-5-96

Installed by: Tim Arrowood

Certificate of Completion by: date

Operation Permit by: Wesley Sparks RS. date 11/4/96

HEALTH DEPT. COPY: WHITE INSPECTION COPY (FINAL): GREEN OWNER COPY (FINAL): YELLOW INSPECTION COPY (INITIAL): PINK OWNER COPY (INITIAL): GOLD