IREDELL COUNTY HEALTH DEPARTMENT

STATESVILLE 704-878-5305 MOORESVILLE 704-664-5281

375.00 Paid

IMPROVEMENT PERMIT / AUTHORIZATION TO CONSTRUCT / OPERATION PERMIT / EXISTING SYSTEM INSPECT

PERMIT# 117242 PIN# 4628 62 7854 DATE 12/17/03

OWNER OR CONTRACTOR James R. Malton PHONE: Business 336-403-6097(c) Home 336-766-3495

ADDRESS 2013 Ashbourne Ln. Clemmons, NC. 27012

LOCATION 150 W TR Peninsula Shores Dr. ~ 1/2 mile TR Emerald Point, 1st lot on (R)

SUBDIVISION Peninsula Shores BLOCK / SECTION 1 LOT 37 LOT AREA ~1.05Ac SITE CLASS. PS DESIGN FLOW 480 L.T.A.R. .3

Septic Tank: 1000 Gallons; STB 794 Date

Pump Tank: 1000 Gallons; PT 27 Date

Pump Make: Myers Model WE-75 Serial No.

Nitrification Field: No Fields 1 Square Feet 540/810 Linear Feet 270

No Lines 10 Trench Width 2 - 3' Max Trench Bottom Depth 3' Gravel Depth NA

[X] New System [ ] Repair System Type: I, II, III, (IV), V, VI

System Description: LP - PPBPS 16"

Repair System Description: SAME

Maintenance Agreement Required: [X] Yes [ ] No

[X] House/Mod. Home No. Bedrooms 4

[ ] Mobile Home No. Bathrooms 4

[ ] Business No. Employees

[ ] Other


[ ] Slab [ ] Crawl Space [X] Basement w/plumbing [ ] Basement wo/plumbing

Water Supply: [ ] Individual [ ] Public [X] Community


Comments/Conditions: 2' on 8' centers, 3' on 9' centers Center Feed Drainfield - Valving as shown here required 1 Delta Valve per line segment with turnups at end of each drainline (1" = 50')

Comments/Conditions: Keep H2O line on left side of lot between driveway and P/L

INITIAL SITE SKETCH

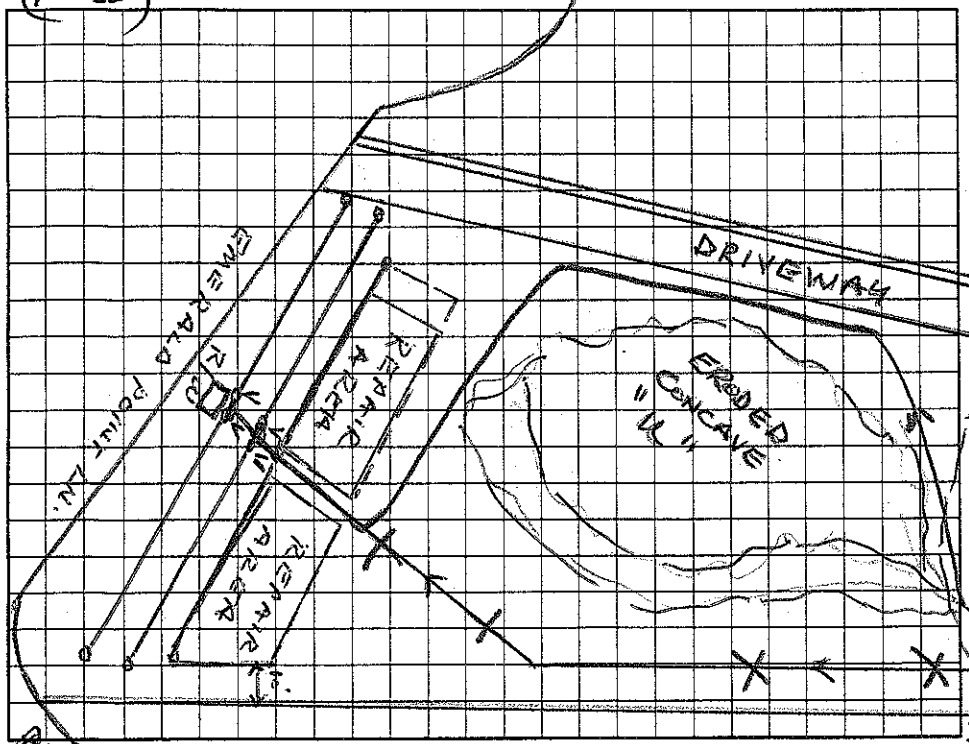

AS BUILT SKETCH

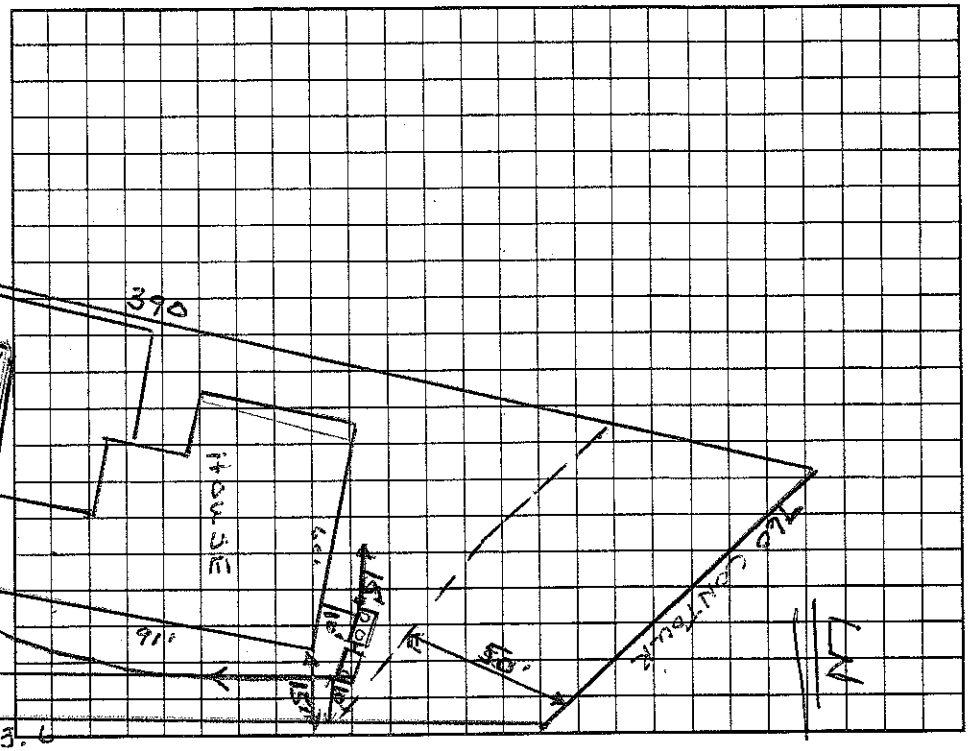

Permit can be suspended or revoked if any false information is supplied toward securing the permit/any unauthorized changes are made to the site/any unauthorized changes are made in the installation of the system. Improvement Permit with site plan valid without expiration. Improvement Permit with site plan valid for sixty months. Authorization to Construct is valid for a period equal to that of Improvement Permit – not to exceed sixty months.

Signed: [signature] date 1/5/04 Installed by: Hartley Septic Service

Improvement Permit by: Wesley Sparks R.S. date 12/17/03 Operation Permit by: Wesley Sparks R.S. date 11-14-05

Authorization to Construct by: Wesley Sparks R.S. date 12/17/03 Existing System Inspection by: date

HEALTH DEPT. COPY: WHITE OWNER COPY (FINAL): YELLOW OWNER COPY (INITIAL): PINK