IREDELL COUNTY HEALTH DEPARTMENT

Authorization to Construct

STATESVILLE 704-878-5305 MOORESVILLE 704-664-5281

IMPROVEMENT PERMIT / ~~CERTIFICATE OF COMPLETION~~ / OPERATION PERMIT / EXISTING SYSTEM INSPECTION

PROPERTY DESCRIPTION NO. 21315 DATE Aug 7 95 TAX MAP NO. ~~part of 2HA20~~ 4628-62-9844 Watershed: ☑ Yes ☐ No

OWNER OR CONTRACTOR ~~Gentry Homes Inc~~ JEAF PALANDJIAN PHONE: Business _____ Home 875-1292 WSY

ADDRESS PO Box 1003 Charlotte

LOCATION 150' W JR Pinnacle Shores Dr. JR Emerald Pt. Lane at end on Right


SUBDIVISION Pinnacle Shores BLOCK / SECTION I LOT 38 LOT AREA 21,780 ft² min SITE CLASS. P5 per T56 DESIGN FLOW 480 gpd L.T.A.R. -3

Septic Tank: 1000 Gallons; STB 12/27/95 Date 7/9/96	☑ New System ☐ Repair System Type: I, II, III, IV, V, VI	☑ House/Mod. Home No. Bedrooms 4	Water Supply:
Pump Tank: 1000 Gallons; PT 27 Date 5/21/96	System Description: LPPBPS	☐ Mobile Home No. Bathrooms 4	☐ Individual
Pump Make: Liberty Model LE61A Serial No.	Repair System Description: LPPBPS	☐ Business No. Employees	☑ Community
Nitrification Field: No Fields 1 Square Feet Linear Feet 270	Maintenance Agreement Required: ☑ Yes ☐ No	☐ Other	☐ Public
No Lines 4 Trench Width 24" Max Trench Bottom Depth ≈ 36" Gravel Depth N/A	☐ Slab ☑ Crawl Space ☑ Basement w/plumbing ☐ Basement wo/plumbing		


Comments: Gate Valves (laterals) can be located in one central valve box.

Comments: ~~DEVELOPER~~ ~~PERMIT~~ partial Tanks, Pump, lines checked 7/12/96.

INITIAL SITE SKETCH 1"=50'

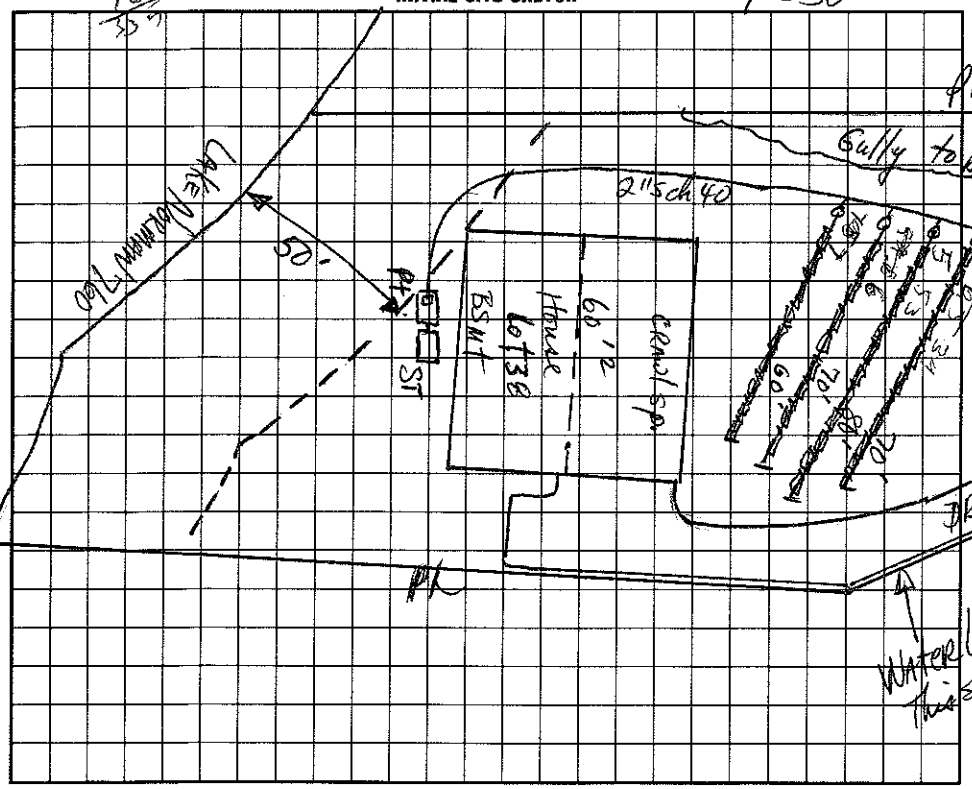

AS BUILT SKETCH

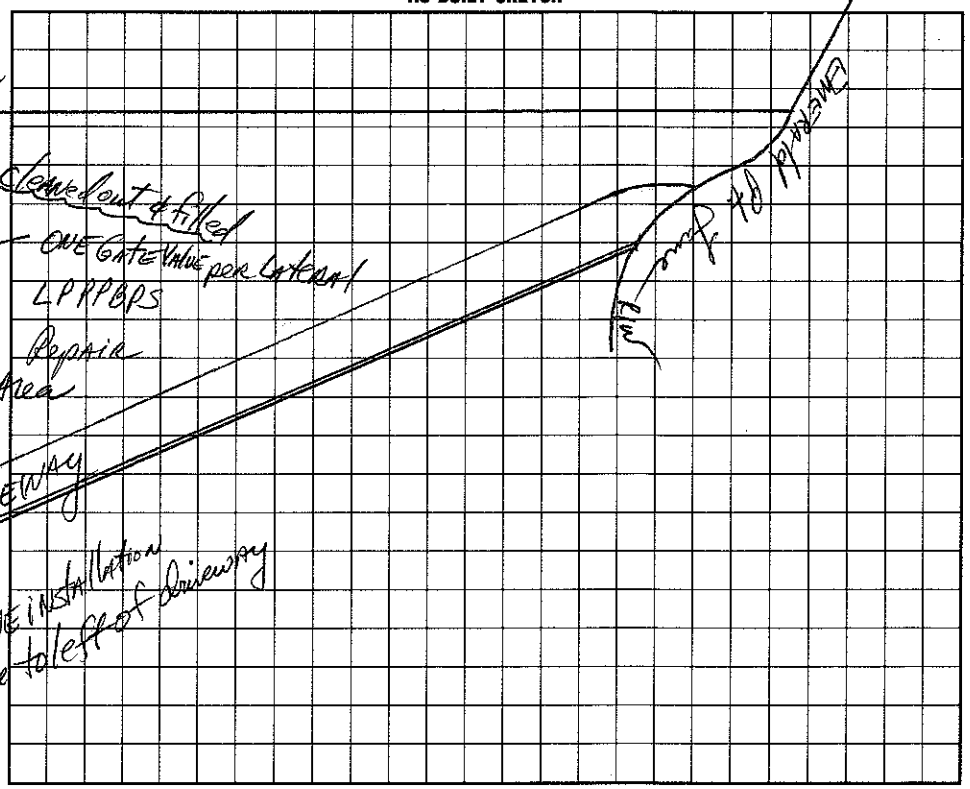

I understand that this permit can be suspended or revoked if any false information is supplied toward securing the permit/any unauthorized changes are made to the site/any unauthorized changes are made in the installation of the system.

Signed: X Craig Gordon-CPSS

Improvement Permit by: Craig Gordon, RS date 8-7-95

Existing System Inspection by: Craig Gordon; Wesley Sparks RS date 12/11/95

Installed by: Ammons

Certificate of Completion by: Wesley Sparks RS date 9/18/96

Operation Permit by: Wesley Sparks RS. date 9/18/96

HEALTH DEPT. COPY: WHITE INSPECTION COPY (FINAL): GREEN OWNER COPY (FINAL): YELLOW INSPECTION COPY (INITIAL): PINK OWNER COPY (INITIAL): GOLD