IREDELL COUNTY HEALTH DEPARTMENT

STATESVILLE 704-878-5305 MOORESVILLE 704-664-5281

IMPROVEMENT PERMIT / CERTIFICATE OF COMPLETION / OPERATION PERMIT / EXISTING SYSTEM INSPECTION

PROPERTY DESCRIPTION NO. 21327 DATE August 7, '95 TAX MAP NO. ~~part of 20A30~~ 4628-63-0132 Watershed: ☑ Yes ☐ No

OWNER OR CONTRACTOR Crescent Resources Inc // Robert Pasternak PHONE: Business _____ Home _____ WS4

ADDRESS PO Box 1003 Charlotte

LOCATION NW TR Pinnacle Shores Drive on left near end

SUBDIVISION Pinnacle Shores BLOCK / SECTION I LOT 54 LOT AREA ± 20,000ft² SITE CLASS. BS pre 1996 DESIGN FLOW 480 gpd L.T.A.R. .3

Septic Tank: 1000 Gallons; STB 786 Date 6/99
Pump Tank: 1000 Gallons; PT 32 Date 6/99
Pump Make: Zoeller Model N163F Serial No 163-002
Nitrification Field: No Fields 1 Square Feet _____ Linear Feet 270
No Lines 3 Lo Trench Width 24" Max Trench Bottom Depth ±30" Gravel Depth N/A

☑ New System ☐ Repair System Type: I, II, III, IV, V, VI
System Description: LPPPBPS
Repair System Description: LPPPBPS
Maintenance Agreement Required: ☑ Yes ☐ No


☑ House/Mod. Home No. Bedrooms 4
☐ Mobile Home No. Bathrooms 4
☐ Business No. Employees _____
☐ Other _____
☐ Slab ☑ Crawl Space ☑ Basement w/plumbing ☐ Basement wo/plumbing

Water Supply:
☐ Individual
☑ Community
☐ Public


Comments: 6-25-99 Reviewed house & site plan; appears substantially in compliance w/ I.P.
* Lowest line Shorter

Comments: DEVELOPER Drain Field & pressure tested 2/24/2000 MS
PERMIT Reviewed for Issuance 6-25-99

INITIAL SITE SKETCH

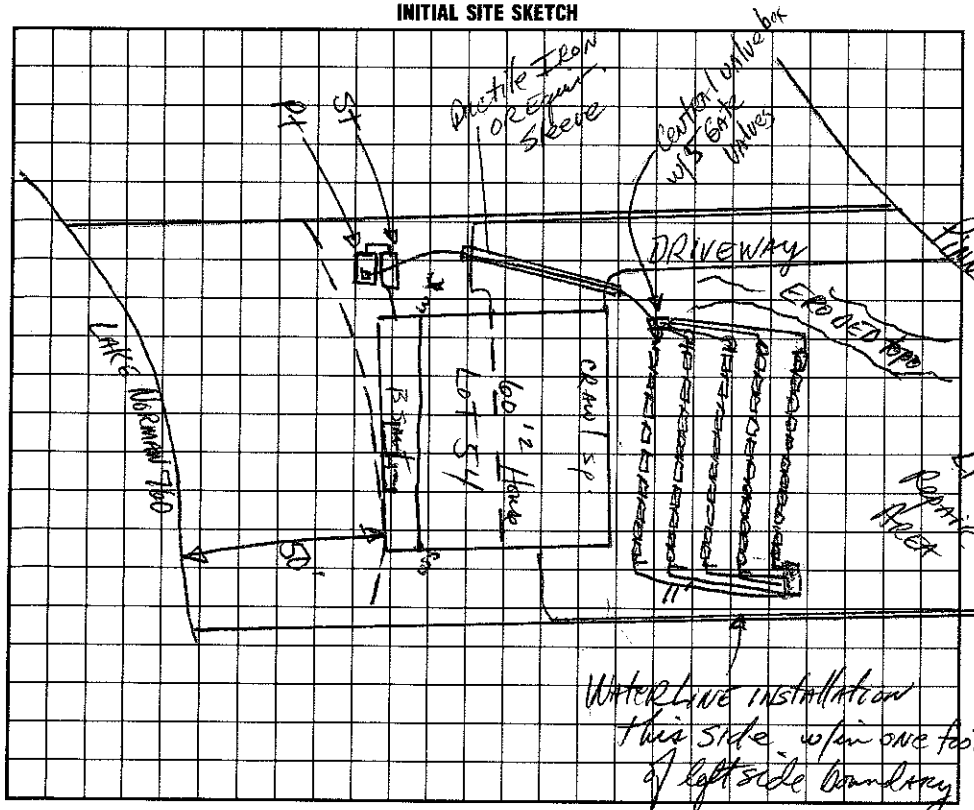

AS BUILT SKETCH

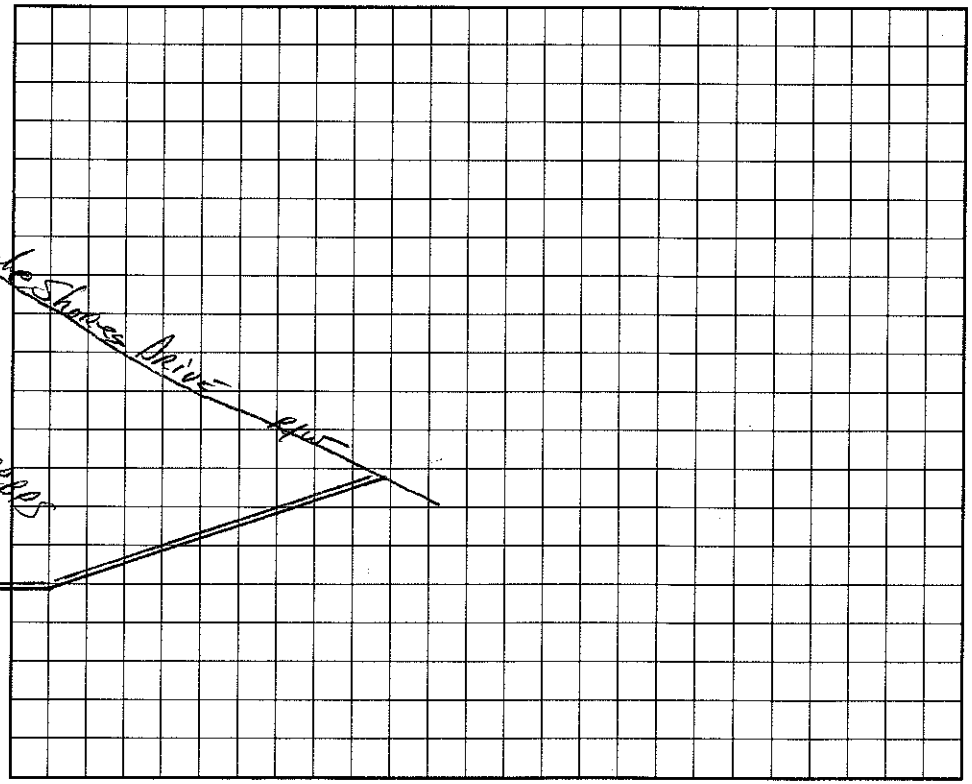

I understand that this permit can be suspended or revoked if any false information is supplied toward securing the permit/any unauthorized changes are made to the site/any unauthorized changes are made in the installation of the system.

Signed: _____

Improvement Permit by: Mark R. Hanson, RS date 8-7-95

~~Existing System Inspection by:~~ Construction Authorization by: Mark R. Hanson, RS date 6-25-99

Installed by: Dennis Hoyle

Certificate of Completion by: Wesley Sparks RS. date 4/14/00

Operation Permit by: Wesley Sparks RS. date 4/14/00

HEALTH DEPT. COPY: WHITE INSPECTION COPY (FINAL): GREEN OWNER COPY (FINAL): YELLOW INSPECTION COPY (INITIAL): PINK OWNER COPY (INITIAL): GOLD