IREDELL COUNTY HEALTH DEPARTMENT

STATESVILLE 704-878-5305 MOORESVILLE 704-664-5281

IMPROVEMENT PERMIT / CERTIFICATE OF COMPLETION / OPERATION PERMIT / EXISTING SYSTEM INSPECTION

PROPERTY DESCRIPTION NO. 22123 DATE Oct 31, '95 TAX MAP NO. part of 2NA20 4628 63 1022 Watershed: ☑ Yes ☐ No

OWNER OR CONTRACTOR John & Mary Williams PHONE: Business / Home 654

ADDRESS 116 Royal Pointe Way, Mooresville

LOCATION 150' W TR Pinnacle Shores Drive on left near end

SUBDIVISION Pinnacle Shores BLOCK / SECTION 1 LOT 55 LOT AREA 1.89 ac SITE CLASS. Bpm 1956 DESIGN FLOW 480 gpd L.T.A.R. n .3

Septic Tank: 1000 Gallons; STB 794 Date 7/97

Pump Tank: 1000 Gallons; PT 27 Date 7/97

Pump Make: MYERS Model MW100-21 Serial No. 9/97

Nitrification Field: No Fields 1 Square Feet 1200 Linear Feet 400

No Lines 6@67' Trench Width 36" Max Trench Bottom Depth ≈ 24" Gravel Depth NA

☑ New System ☐ Repair System Type: I, II, (III), IV, V, VI

System Description: pumped pressure / Infiltrator

Repair System Description: Same

Maintenance Agreement Required: ☐ Yes ☑ No

☑ House/Mod. Home No. Bedrooms 4

☐ Mobile Home No. Bathrooms 3

☐ Business No. Employees

☐ Other

☐ Slab ☐ Crawl Space ☑ Basement w/plumbing ☐ Basement wo/plumbing

Water Supply: ☐ Individual ☑ Community ☐ Public


Comments:

MAY SMITH SUPPLY LINE LOCATION


- HIS ON SIDE OF - SEWER LINE ON BOTTOM -

Comments: System heavily rained in before covering

INITIAL SITE SKETCH 10/22/97

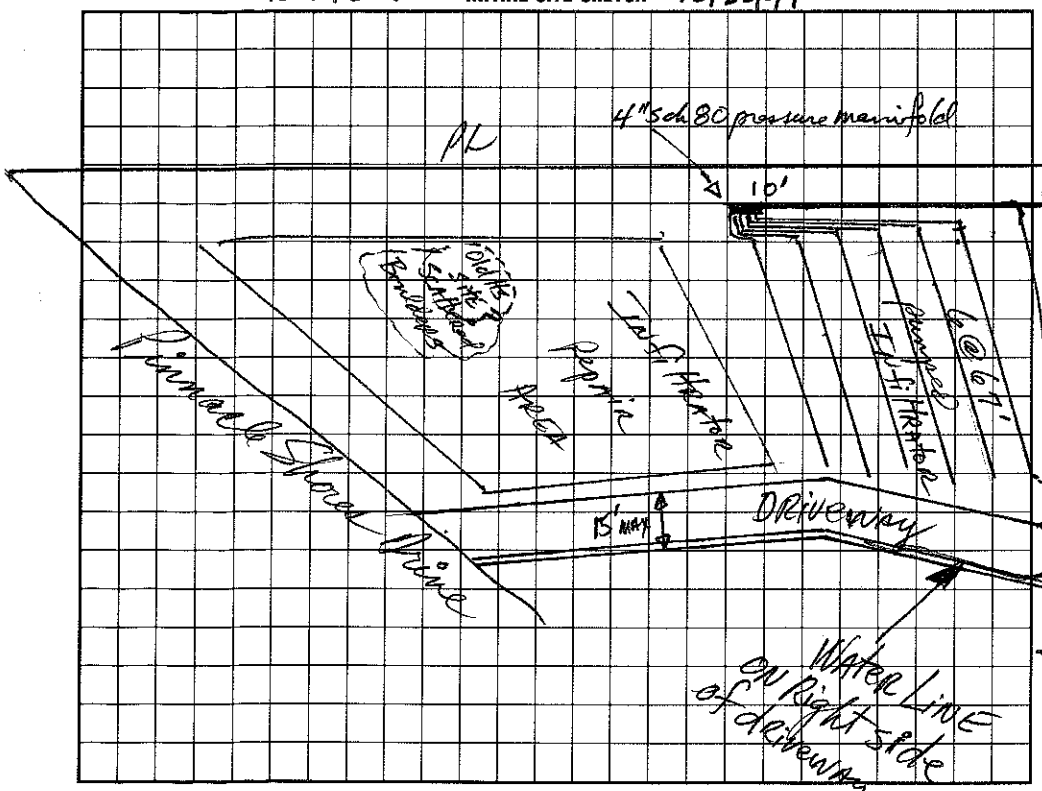

AS BUILT SKETCH

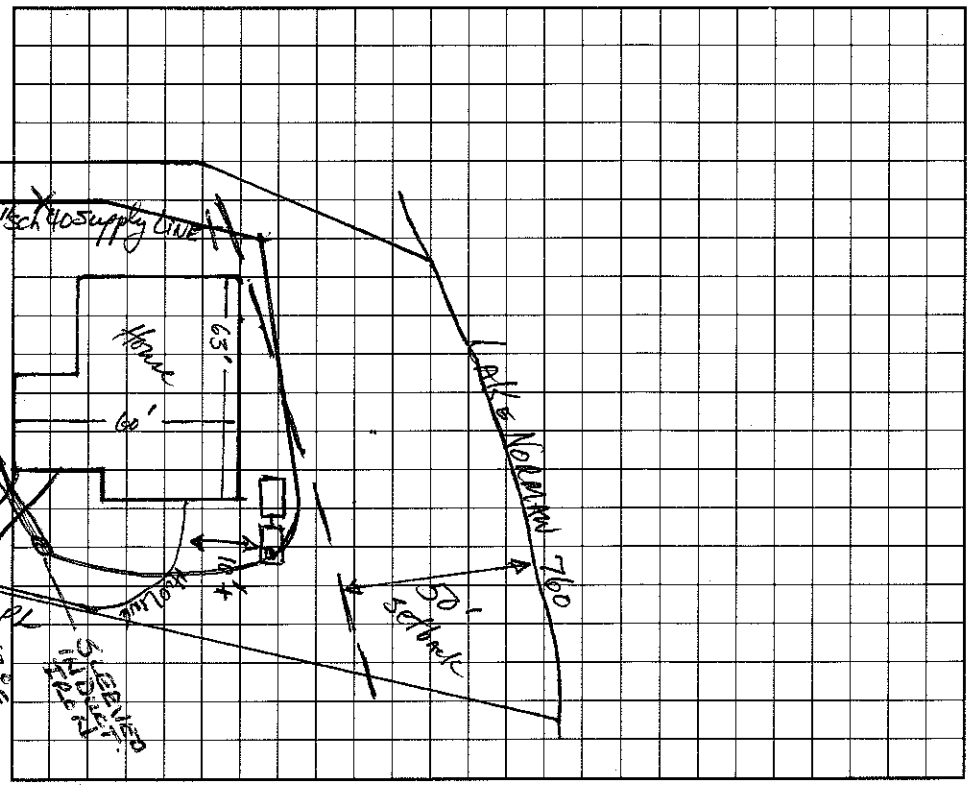

I understand that this permit can be suspended or revoked if any false information is supplied toward securing the permit/any unauthorized changes are made to the site/any unauthorized changes are made in the installation of the system.

Signed: John & Mary Williams

Improvement Permit by: Dave L. Hunsucker RS date 10/31/95

~~Existing System Inspection by:~~ Dave L. Hunsucker RS date 10/31/95

Installed by: Jerry Bradley

Certificate of Completion by: Wesley Sparks RS. date 11/5/97

Operation Permit by: Wesley Sparks RS. date 11/5/97

Auth to Construct

HEALTH DEPT. COPY: WHITE INSPECTION COPY (FINAL): GREEN OWNER COPY (FINAL): YELLOW INSPECTION COPY (INITIAL): PINK OWNER COPY (INITIAL): GOLD