Grainda Builders / Timothy Small

IREDELL COUNTY HEALTH DEPARTMENT

STATESVILLE 704-878-5305 315.00 Paid MOORESVILLE 704-664-5281

IMPROVEMENT PERMIT / AUTHORIZATION TO CONSTRUCT / OPERATION PERMIT / EXISTING SYSTEM INSPECTION

PERMIT# 109975 PIN# 4628631598 DATE 1-7-04

OWNER OR CONTRACTOR Carmen De Andrea Jr. / ~~Simonini~~ PHONE: Business 309-3253 Brian Hall Home 791-8029 Carmen's mobile

ADDRESS P.O. Box 5327 Concord, NC 28027

LOCATION Hwy 150 W TR on Pinnacle Shores Dr, take to end on right of Cul-de-sac

SUBDIVISION Pinnacle Shores BLOCK / SECTION 1 LOT 49 LOT AREA .90 Acre SITE CLASS PS DESIGN FLOW 480 gpd L.T.A.R. .3

Septic Tank: 1000 Gallons; STB 794 Date 1-16-06
Pump Tank: 1000 Gallons; PT 27 Date 1-13-06
Pump Make: Goulds Model WE03J2M1 Serial No.
Nitrification Field: No. Fields 1 Square Feet 540-810 Linear Feet 270'
No. Lines 3@90' Trench Width 24"-36" Max Trench Bottom Depth 30" Gravel Depth N/A

☒ New System ☐ Repair System Type: I, II, III, IV, V
System Description: Pump (LP) Panel Block
Repair System Description: Same
Maintenance Agreement Required: ☒ Yes ☐ No


☒ House/Mod. Home No. Bedrooms 4
☐ Mobile Home No. Bathrooms 4½
☐ Business No. Employees
☐ Other
☐ Slab ☐ Crawl Space ☒ Basement w/plumbing ☐ Basement wo/plumbing

Water Supply: ☐ Individual ☐ Public ☒ Community


Comments:/Conditions: Very tight site, drive must not ~~cross~~ cross drain field area. Keep Septic System at least 10' from PL & 50' from lake.

Comments:/Conditions: Notes Per Survey map dated 12-22-03, 760 contour line follows along Seawall
3/30/06 Checked tanks & lines
4/21/06 Checked pressure, elect & alarm 4/21/06

INITIAL SITE SKETCH Scale 1:50

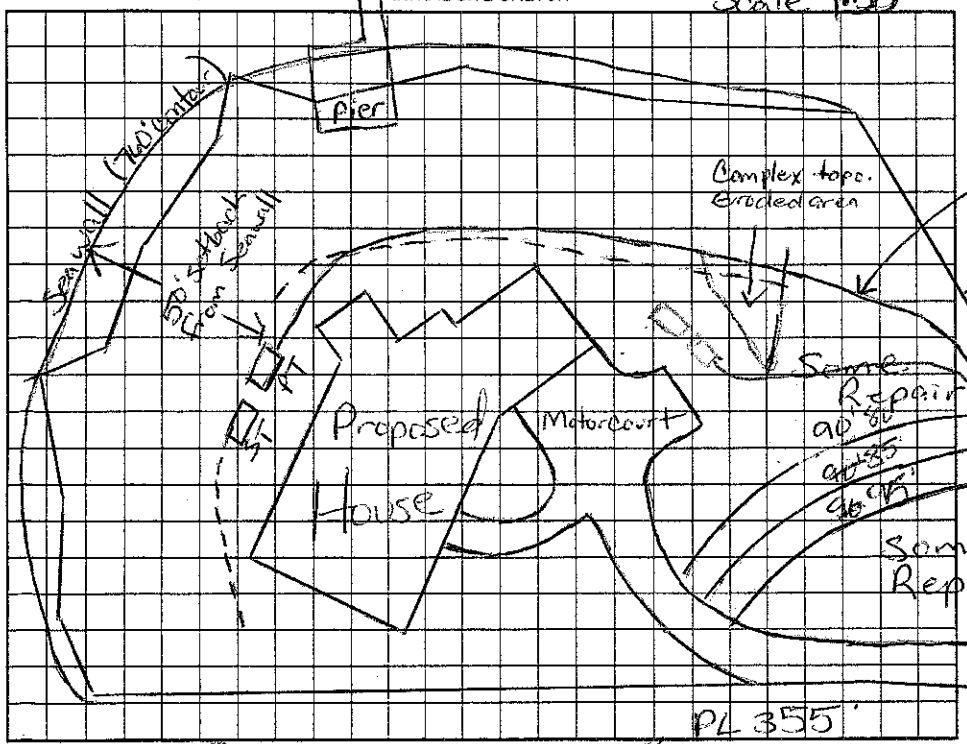

AS BUILT SKETCH

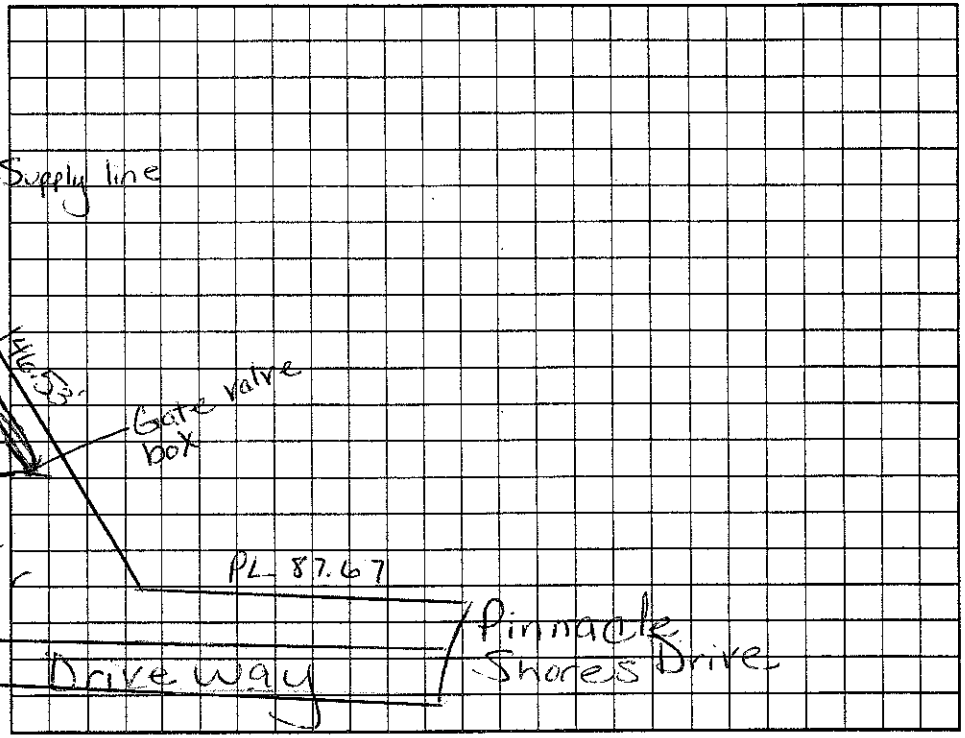

Permit can be suspended or revoked if any false information is supplied toward securing the permit/any unauthorized changes are made to the site/any unauthorized changes are made in the installation of the system. Improvement Permit with plat valid without expiration. Improvement Permit with ~~site plan~~ valid for sixty months. Authorization to Construct is valid for a period equal to that of Improvement Permit – not to exceed sixty months.

Signed: [signature] date 1-21-04

Improvement Permit by: Maria H. Dotson RS date 1/7/04

Authorization to Construct by: Maria H. Dotson RS date 1/7/04

Installed by:

Operation Permit by: Maria H. Dotson RS date 4/25/06

Existing System Inspection by: date

HEALTH DEPT. COPY: WHITE OWNER COPY (FINAL): YELLOW OWNER COPY (INITIAL): PINK