IREDELL COUNTY HEALTH DEPARTMENT

STATESVILLE 704-878-5305 MOORESVILLE 704-664-5281

(2.30-3600)

IMPROVEMENT PERMIT / CERTIFICATE OF COMPLETION / OPERATION PERMIT / EXISTING SYSTEM INSPECTION

PROPERTY DESCRIPTION NO. 21321 DATE Aug 9, '95 TAX MAP NO. ~~part of 20A20~~ 4628-63-2263 Watershed: ☑ Yes ☐ No

OWNER OR CONTRACTOR Crescent Resources Inc // K2 Custom Builders PHONE: Business _____ Home _____ WSF

ADDRESS PO Box 1003, Charlotte

LOCATION 150 W ~~FR~~ Pinnacle Shores Drive on Right near end

SUBDIVISION Pinnacle Shores BLOCK / SECTION 1 LOT 47 LOT AREA ≥ 20,000 ft² SITE CLASS. I.S per 1996 DESIGN FLOW 480 gpd L.T.A.R. .3

Septic Tank: 1000 Gallons; STB 744 Date 3/12/96

Pump Tank: 1000 Gallons; PT 27 Date 9/3/96

Pump Make: Gould Model ~~5 HP WL05 111~~ Serial No. M94J220J

Nitrification Field: No Fields 1 Square Feet _____ Linear Feet 270

No Lines ~4 Trench Width 24" Max Trench Bottom Depth ≈ 30" Gravel Depth N/A

☐ New System ☐ Repair System Type: I, II, III, ☑ IV, V, VI

System Description: LPPBPS

Repair System Description: off site LPPBPS or INF.

Maintenance Agreement Required: ☑ Yes ☐ No

☑ House/Mod. Home No. Bedrooms 4

☐ Mobile Home No. Bathrooms 4

☐ Business No. Employees _____

☐ Other _____

☐ Slab ☑ Crawl Space ☑ Basement w/plumbing ☐ Basement wo/plumbing


Water Supply: ☐ Individual ☑ Community ☐ Public

Comments: Laterals to follow contour. Old road bed to be properly filled & Repair area is in offsite sewer easement.


Comments: DEVELOPER PERMIT Ready to issue C.O. pending partial 3/1/96 DRH

(TANKS, PRESSURE, LINES checked NV. 4" CBF)

INITIAL SITE SKETCH

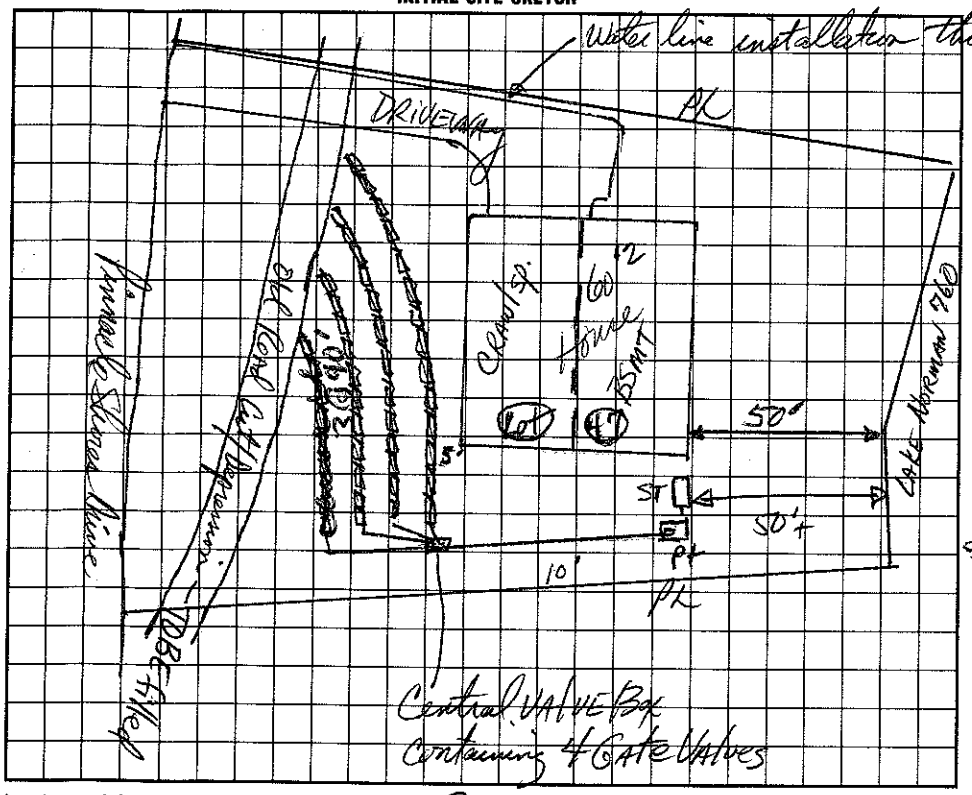

AS BUILT SKETCH

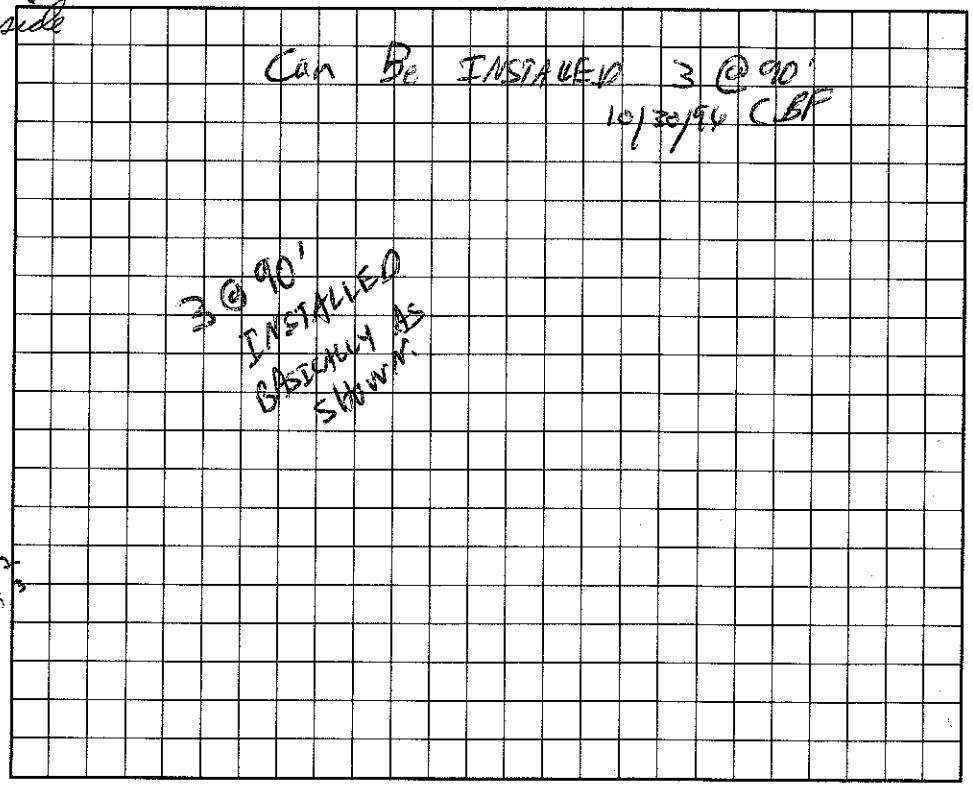

I understand that this permit can be suspended or revoked if any false information is supplied toward securing the permit/any unauthorized changes are made to the site/any unauthorized changes are made in the installation of the system.

Signed: X Travis C. Jenkins, EHS

Improvement Permit by: Travis C. Jenkins, RS date 8-9-95

~~Existing System Inspection by:~~ Authorization to construct by: Travis C. Jenkins, RS date 3-1-96

Installed by: DENVER PLUMBING CO.

Certificate of Completion by: _____ date _____

Operation Permit by: C. Ray Thomas EHSI date 11/7/96

HEALTH DEPT. COPY: WHITE INSPECTION COPY (FINAL): GREEN OWNER COPY (FINAL): YELLOW INSPECTION COPY (INITIAL): PINK OWNER COPY (INITIAL): GOLD