(3:30-)

IREDELL COUNTY HEALTH DEPARTMENT Const. Auth. STATESVILLE 704-878-5305 MOORESVILLE 704-664-5281

IMPROVEMENT PERMIT / ~~CERTIFICATE OF COMPLETION~~ / OPERATION PERMIT / EXISTING SYSTEM INSPECTIO

PROPERTY DESCRIPTION NO. 21320 DATE Aug 4, '97 (TEST A) TAX MAP NO. part of 2WA20 4628-63-3178 Watershed: ☑ Yes ☐ No

OWNER OR CONTRACTOR Kenneth & Ellen White PHONE: Business _____ Home _____ WS4CA

ADDRESS 248 Bostian LK Rd Statesville

LOCATION 150 W TR Pinnacle Shores Dr. on Right 2nd Lot past Emerald Pt. Lane

SUBDIVISION Pinnacle Shores BLOCK / SECTION 1 LOT 46 LOT AREA .64ac SITE CLASS PS DESIGN FLOW 460gpd L.T.A.R. .3

Septic Tank: 1000 Gallons; STB 794 Date 11/2/95 ☑ New System ☐ Repair System Type: I, II, III, IV, V, VI ☑ House/Mod. Home No. Bedrooms 4

Pump Tank: 1000 Gallons; PT 27 Date 7/26/95 System Description: LP Panel Bldg ☐ Mobile Home No. Bathrooms 4

Pump Make: HYDROMATIC Model 50A1 Serial No. _____ Repair System Description: Same ☐ Business No. Employees _____

Nitrification Field: No Fields 1 Square Feet 534 Linear Feet 267 Maintenance Agreement Required: ☑ Yes ☐ No ☐ Other _____

No Lines 4 Trench Width 24" Max Trench Bottom Depth ~ 30" Gravel Depth N/A ☐ Slab ☑ Crawl Space ☐ Basement w/plumbing ☐ Basement wo/plumbing


Water Supply: ☐ Individual ☑ Community ☐ Public

Comments: This permit replaces permit of 9-28-95 issued to Crescent Resources.

Comments:

1" = 50'

INITIAL SITE SKETCH

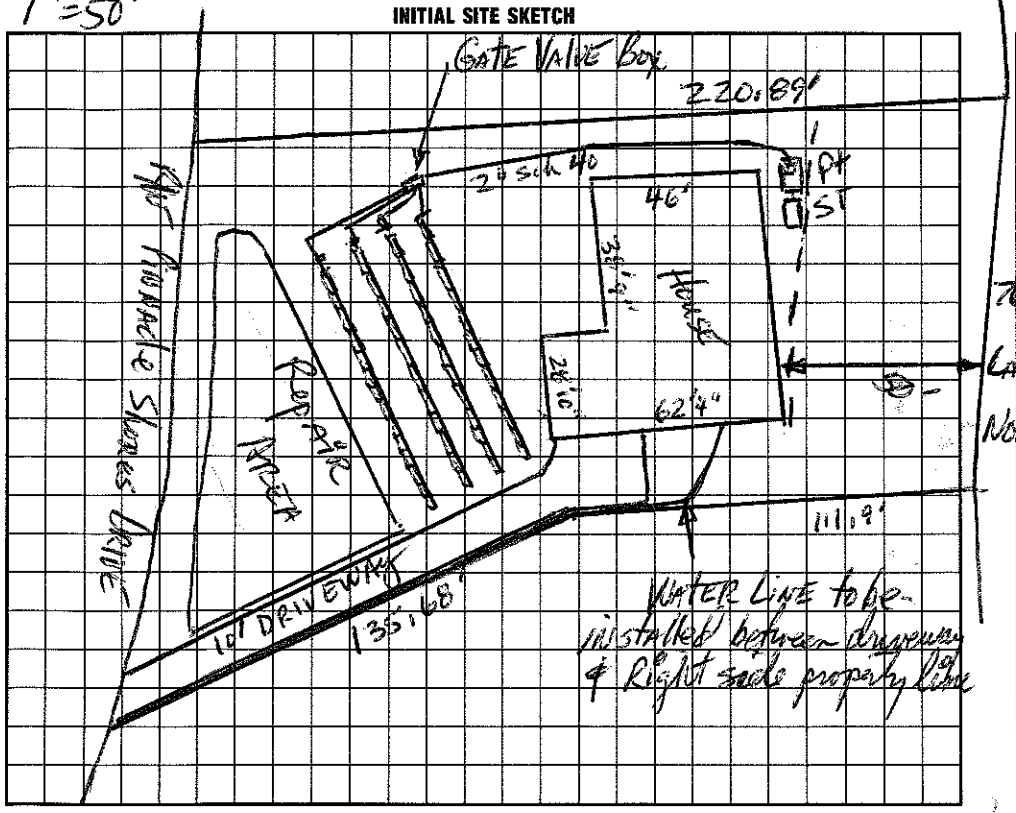

AS BUILT SKETCH

I understand that this permit can be suspended or revoked if any false information is supplied toward securing the permit/any unauthorized changes are made to the site/any unauthorized changes are made in the installation of the system. Improvement Permit is valid for 60 months from date of issuance.

Signed: X D. H. Gladden Jr.

Improvement Permit by: D R Hamm, RS date 8-4-97

Construction ~~Existing System~~ Inspection by: D R Hamm, RS date 8-4-97

Installed by: ORBISON

Certificate of Completion by: Wesley Sparks R.S. date 7/14/98

Operation Permit by: Wesley Sparks R.S. date 7/14/98

Authorized

HEALTH DEPT. COPY: WHITE INSPECTION COPY (FINAL): GREEN OWNER COPY (FINAL): YELLOW INSPECTION COPY (INITIAL): PINK OWNER COPY (INITIAL): GOLD