IREDELL COUNTY HEALTH DEPARTMENT

STATESVILLE 704-878-5305 130.00 Paid MOORESVILLE 704-664-5281

IMPROVEMENT PERMIT / AUTHORIZATION TO CONSTRUCT / OPERATION PERMIT / EXISTING SYSTEM INSPECTION

PERMIT# 10269 PIN# 4628-63-4183 DATE

OWNER OR CONTRACTOR Stongate Luxury Homes PHONE: Business 704-987-1899 Home

ADDRESS PO Box 1597 Cornelius NC 28031

LOCATION 150W, TR Pinnacle Shores Dr., on Rt past Emerald Pt.

SUBDIVISION Pinnacle Shores BLOCK / SECTION 1 LOT 45/45A LOT AREA 0.734C SITE CLASS PS DESIGN FLOW 480 L.T.A.R. 0.3

Septic Tank: 1000 Gallons; STB Date

Pump Tank: 1000 Gallons; PT Date

Pump Make: Gould Model WE15T2HH Serial No C03L2488

Nitrification Field: No Fields 1 Square Feet 1200 Linear Feet 400

No Lines 4 @ 100' Trench Width 36" Max Trench Bottom Depth 36" Gravel Depth —

☒ New System ☐ Repair System Type: I, II, (III), IV, V, VI

System Description: Pressure Man. 25% Red.

Repair System Description: LT Panel Block

Maintenance Agreement Required: ☐ Yes ☒ No

☒ House/Mod. Home ☐ Mobile Home ☐ Business ☐ Other

No. Bedrooms 4 No. Bathrooms 4.5 No. Employees


☐ Slab ☐ Crawl Space ☒ Basement w/plumbing ☐ Basement wo/plumbing

Water Supply: ☐ Individual ☐ Public ☒ Community


Comments:/Conditions:

Comments:/Conditions: Checked tanks 4/3/03 Checked lines 8/13/03 mp Outside alarm installed 4/23/04

INITIAL SITE SKETCH

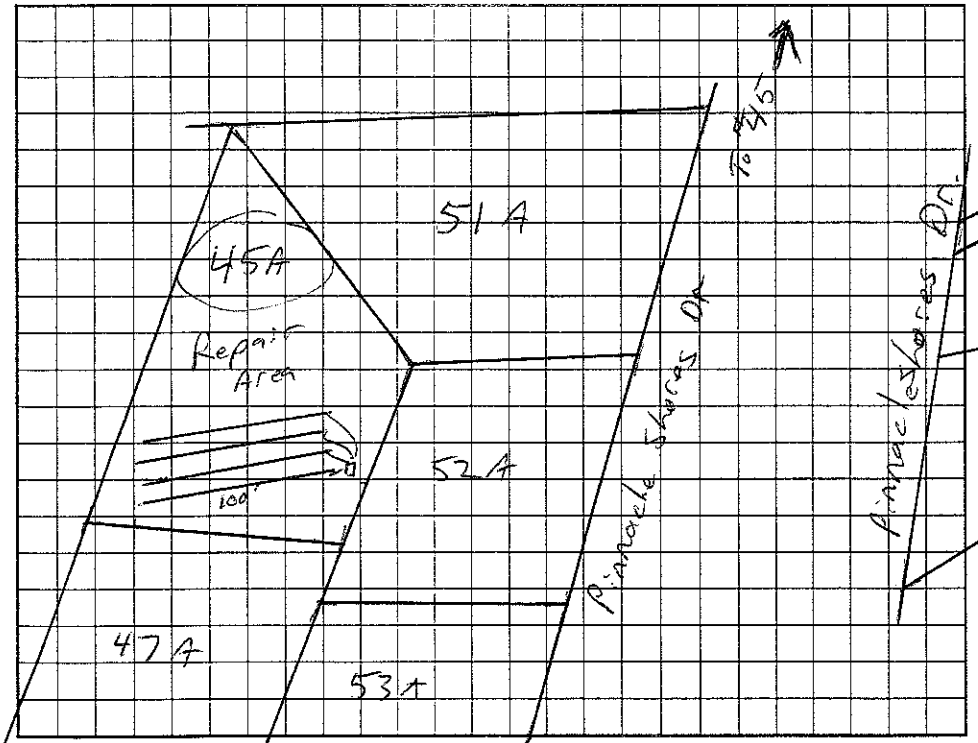

AS BUILT SKETCH

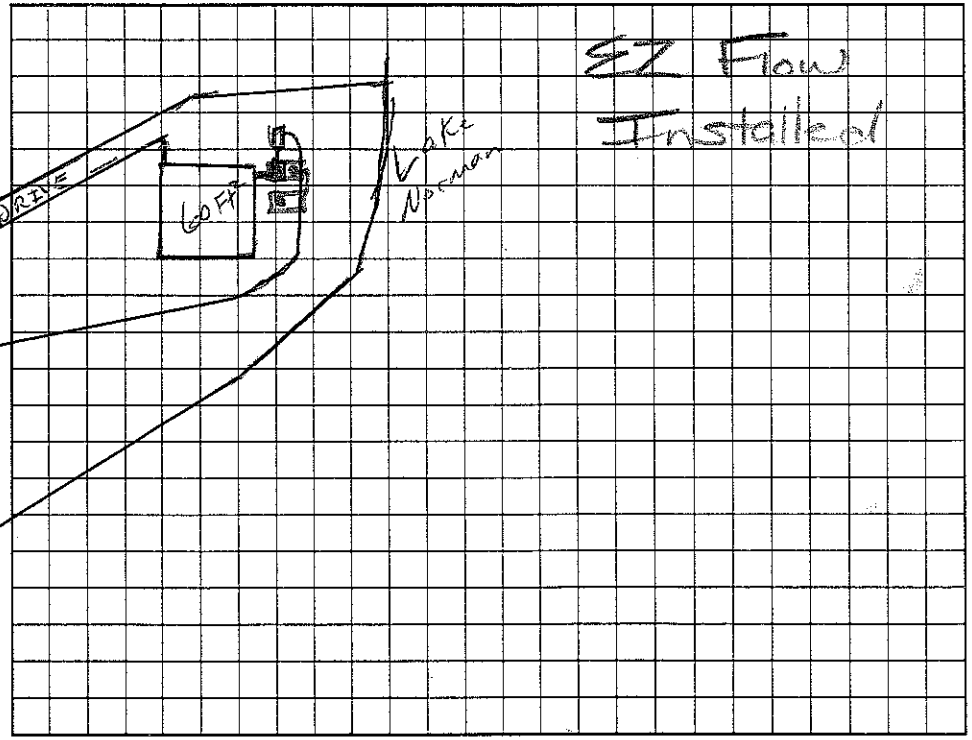

Permit can be suspended or revoked if any false information is supplied toward securing the permit/any unauthorized changes are made to the site/any unauthorized changes are made in the installation of the system. Improvement Permit with plat valid without expiration. Improvement Permit with site plan valid for sixty months. Authorization to Construct is valid for a period equal to that of Improvement Permit – not to exceed sixty months.

Signed: plantation Dr. date 11-8-02 Installed by: R & H Inc / Steve Jordan

Improvement Permit by: RS date 10/30/02 Operation Permit by: Wesley Sparks RS. date 4/23/04

Authorization to Construct by: RS date 10/30/02 Existing System Inspection by: date

HEALTH DEPT. COPY: WHITE OWNER COPY (FINAL): YELLOW OWNER COPY (INITIAL): PINK