IREDELL COUNTY HEALTH DEPARTMENT

Statesville Phone TR 3-7271 Mooresville Phone NO 3-1271

PERMIT TO INSTALL SEPTIC TANK

Permit NO. [illegible] Permit Date May 12 1969

Owner Dr. John Hardaway Address Sta.

Installed By C Hoke & Sons Address [illegible]


Location of Property out Catt Ch. Rd. R - old Rock Ch. left Laird Rd before State Park - hold main state Right at fork on circle on R -

Tank		Capacity		Length of Lines		Fixtures	
Block	( )	1000	( )	225'	( )	No. of Baths	(2½
Precast	(✓)	1250	(✓)	250'	( )	Dishwasher	( )
Adams		1500	( )	Other 270' 675 sq ft.		Garbage Grdr.	( )
		Other				Other	

NOTIFY HEALTH DEPARTMENT AT LEAST EIGHT HOURS BEFORE TANK IS TO BE INSPECTED.

Final Inspection 19 Approved (✓) Disapproved ( )

Remarks Summer home - very confined area - heavy woods. Prop. lines - home - well - plumbing and lake prevent a real good layout. owners did not want to take out any trees well 60'

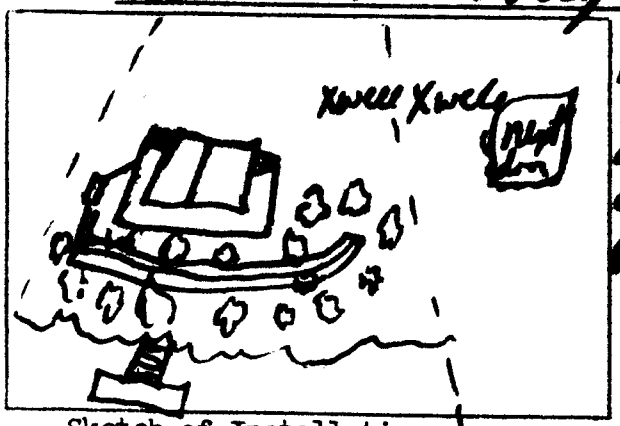

Sketch of Installation

Sanitarian