IREDELL COUNTY HEALTH DEPARTMENT

STATESVILLE 704-878-5305 MOORESVILLE 704-664-5281

IMPROVEMENT PERMIT / AUTHORIZATION TO CONSTRUCT / OPERATION PERMIT / EXISTING SYSTEM INSPECTION

PERMIT# 21933 PIN# ~~pt of 3NA20~~ 4628-70-4814 DATE 7/8/98

OWNER OR CONTRACTOR MARSHALL BLD GROUP PHONE: Business Home 896-5552

ADDRESS ~~PO BOX 1003 CHARLOTTE~~ 19701-D HWY 73 CORNELIUS NC 28031

LOCATION 150 W- TR LONG COVE RD - ~ 600' ON LT

SUBDIVISION PINNACLE SHORE BLOCK / SECTION II LOT 3 LOT AREA - SITE CLASS. RS DESIGN FLOW ~~@360 GPD~~ L.T.A.R. .3

Septic Tank: 1000 Gallons; STB ~~@ 47~~ Date 3/4/99

Pump Tank: 1000 Gallons; PT @ 47 Date 1/10/99

Pump Make: HYDROMATIC Model SHEF50A1 Serial No. 4/99

Nitrification Field: No Fields 1 Square Feet 900 Linear Feet 300

No Lines ~~5 @ 360~~ Trench Width 36" Max Trench Bottom Depth 36" Gravel Depth N/A

☑ New System ☐ Repair System Type: I, II, III, IV, V, VI

System Description: PUMP CHAMBERS OR HOS

Repair System Description: SAME

Maintenance Agreement Required: ☐ Yes ☑ No

☑ House/Mod. Home ☐ Mobile Home ☐ Business ☐ Other

No. Bedrooms 3 No. Bathrooms 3 No. Employees

☐ Slab ☐ Crawl Space ☑ Basement w/plumbing ☐ Basement wo/plumbing


Water Supply: ☐ Individual ☐ Public ☑ ~~Community~~

Comments:/Conditions: 5 lines - 2 PM Boxes


Comments:/Conditions:

Lot Address: 127 Long Cove Rd - Mikael

INITIAL SITE SKETCH 1"=50'

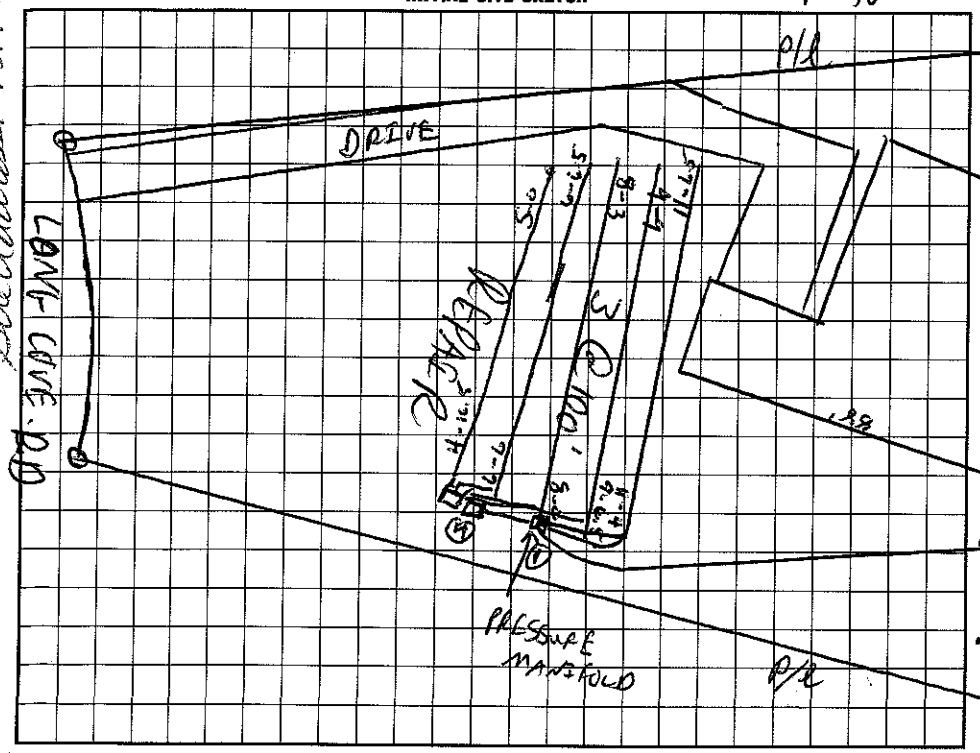

AS BUILT SKETCH

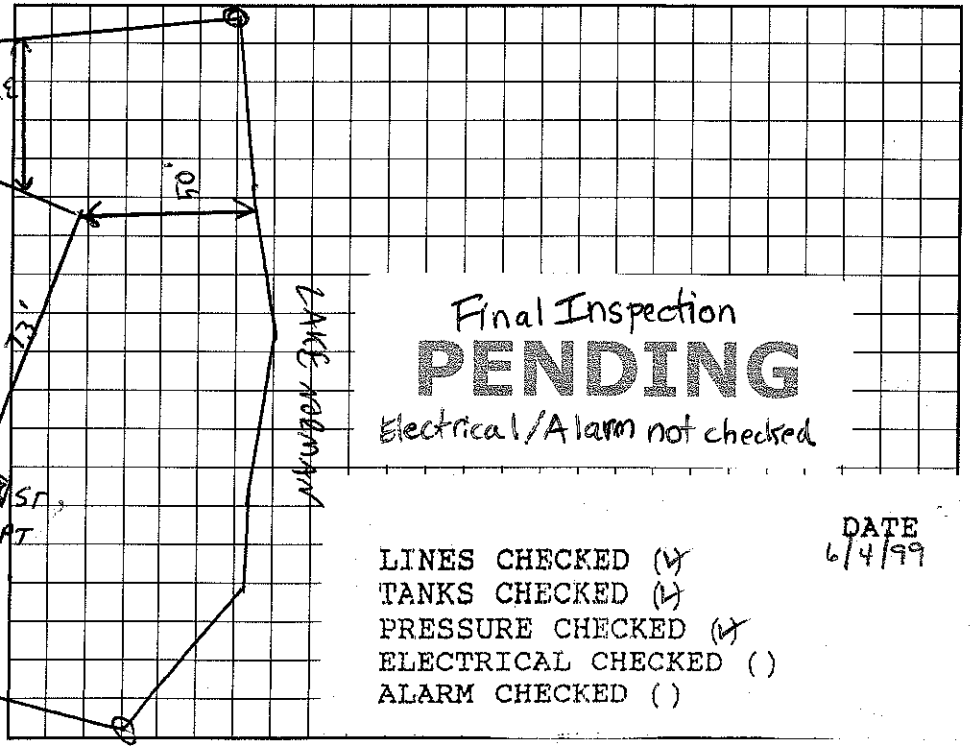

Final Inspection

PENDING

Electrical/Alarm not checked

DATE 6/4/99

LINES CHECKED (✓)
TANKS CHECKED (✓)
PRESSURE CHECKED (✓)
ELECTRICAL CHECKED ( )
ALARM CHECKED ( )

I understand that this permit can be suspended or revoked if any false information is supplied toward securing the permit/any unauthorized changes are made to the site/any unauthorized changes are made in the installation of the system. Improvement Permit with plat valid without expiration. Improvement Permit with site plan valid for sixty months. Authorization to Construct is valid for a period equal to that of Improvement Permit – not to exceed sixty months.

Signed: [signature] date 7/10/98 Installed by: Rodney Ellis

Improvement Permit by: [signature] RS date 7/8/98 Operation Permit by: date

Authorization to Construct by: [signature] RS date 7/8/98 Existing System Inspection by: date

HEALTH DEPT. COPY: WHITE INSPECTION COPY (FINAL): GREEN OWNER COPY (FINAL): YELLOW INSPECTION COPY (INITIAL): PINK OWNER COPY (INITIAL): GOLD