(11.00)

IREDELL COUNTY HEALTH DEPARTMENT

STATESVILLE 704-878-5305 MOORESVILLE 704-664-528[illegible]

IMPROVEMENT PERMIT / AUTHORIZATION TO CONSTRUCT / OPERATION PERMIT / EXISTING SYSTEM INSPECTION

PERMIT# 21934 PIN# part of 2NA20 4628 70 4994 DATE Oct-26, '98

OWNER OR CONTRACTOR Crescent Resources Chas John Leggett PHONE: Business _____ Home _____

ADDRESS PO Box 1003 Charlotte 714 Carson Ct, Kannapolis

LOCATION 150W of TR. Lous Cove Rd. on left

SUBDIVISION Pinnacle Shores BLOCK / SECTION II LOT 4 LOT AREA ≥ 20,000 sf SITE CLASS. PS DESIGN FLOW 480 gpd L.T.A.R. .03

Septic Tank: 1000 Gallons; STB 625 Date 5/4/99
Pump Tank: 1000 Gallons; PT 302 Date 7/1/99
Pump Make: _____ Model _____ Serial No. _____
Nitrification Field: No Fields 1 Square Feet 1200 Linear Feet 400
No Lines 5 & 6 Trench Width 36" Max Trench Bottom Depth 36" Gravel Depth NA

☑ New System ☐ Repair System Type: I, II, III, IV, V, VI
System Description: pumped pmt 25% Red. Innovative
Repair System Description: LP Panel Block
Maintenance Agreement Required: ☐ Yes ☑ No initially

☑ House/Mod. Home No. Bedrooms 4
☐ Mobile Home No. Bathrooms 3½
☐ Business No. Employees ____
☐ Other _____
☐ Slab ☑ Crawl Space ☑ Basement w/plumbing ☐ Basement wo/plumbing


Water Supply: ☐ Individual ☑ Public ☐ Community

Comments:/Conditions: * ONE inspection port per LATERAL.


Comments:/Conditions: (PARTIAL) Pressure checked 8/26/99. mp

1"=50'

INITIAL SITE SKETCH

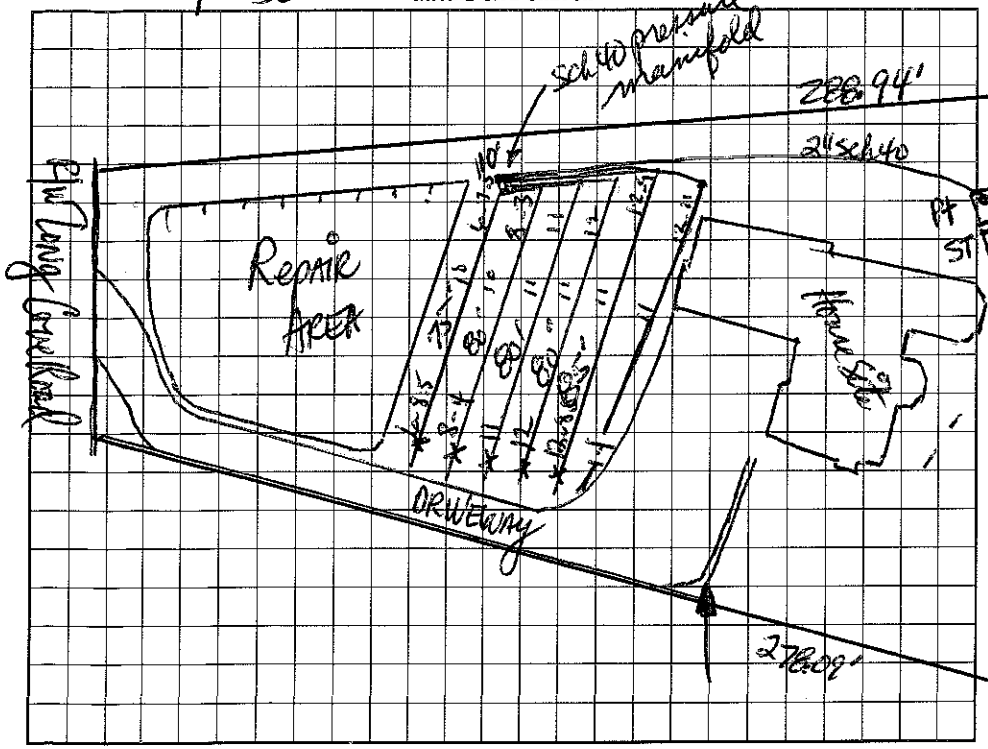

AS BUILT SKETCH

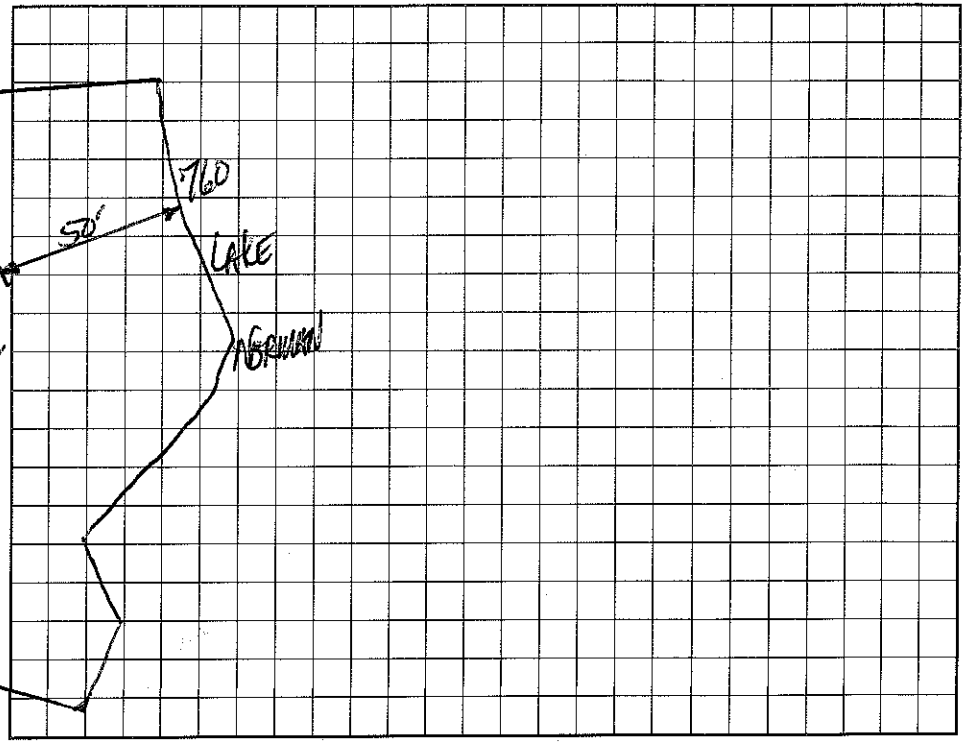

I understand that this permit can be suspended or revoked if any false information is supplied toward securing the permit/any unauthorized changes are made to the site/any unauthorized changes are made in the installation of the system. Improvement Permit ~~with plat valid without~~ expiration. Improvement Permit with site plan valid for sixty months. Authorization to Construct is valid for a period equal to that of Improvement Permit – not to exceed sixty months.

Signed: _____ date 10/27/98 Installed by: Delbert Bostian

Improvement Permit by: _____ date 10-26-98 Operation Permit by: Wesley Parks RS. date 1/10/00

Authorization to Construct by: _____ date 10-26-98 Existing System Inspection by: _____ date _____

HEALTH DEPT. COPY: WHITE INSPECTION COPY (FINAL): GREEN OWNER COPY (FINAL): YELLOW INSPECTION COPY (INITIAL): PINK OWNER COPY (INITIAL): GOLD