IREDELL COUNTY HEALTH DEPARTMENT

STATESVILLE 704-878-5305 MOORESVILLE 704-664-5281

IMPROVEMENT PERMIT / AUTHORIZATION TO CONSTRUCT / OPERATION PERMIT / EXISTING SYSTEM INSPECTION

PERMIT# 21935 PIN# ~~pt of 2NA20~~ 4628-70-6929 DATE 2/4/98

OWNER OR CONTRACTOR ROB SMITH PHONE: Business 873-8047 Home

ADDRESS

LOCATION 150 W - TR LONG COVE RD - AT END ON LT

SUBDIVISION PINNACLE SHORES BLOCK / SECTION II LOT 5 LOT AREA SITE CLASS. PS DESIGN FLOW 480 gpd L.T.A.R. .3 gpd/ft²

Septic Tank: 1000 Gallons; STB 794 Date 1/23/98
Pump Tank: 1000 Gallons; PT 27 Date 4/7/98
Pump Make: GOULDS Model WE0-7124 Serial No. L9812173
Nitrification Field: No Fields 1 Square Feet 533 Linear Feet 370
No Lines 3 Trench Width ~~24"~~ 36" Max Trench Bottom Depth ≈ 30" Gravel Depth N/A

☑ New System ☐ Repair System Type: I, II, III, IV, V, VI
System Description: PRESSURE PANEL
Repair System Description: SAME
Maintenance Agreement Required: ☑ Yes ☐ No

☑ House/Mod. Home No. Bedrooms 4
☐ Mobile Home No. Bathrooms 4
☐ Business No. Employees
☐ Other


☐ Slab ☐ Crawl Space ☑ Basement w/plumbing ☐ Basement wo/plumbing

Water Supply: ☐ Individual ☐ Public ☑ Community

Comments:/Conditions: 5" Tether

Comments:/Conditions: 5/14/99 Heavily graded - heavy compaction in front yard area.

INITIAL SITE SKETCH 1"=50'

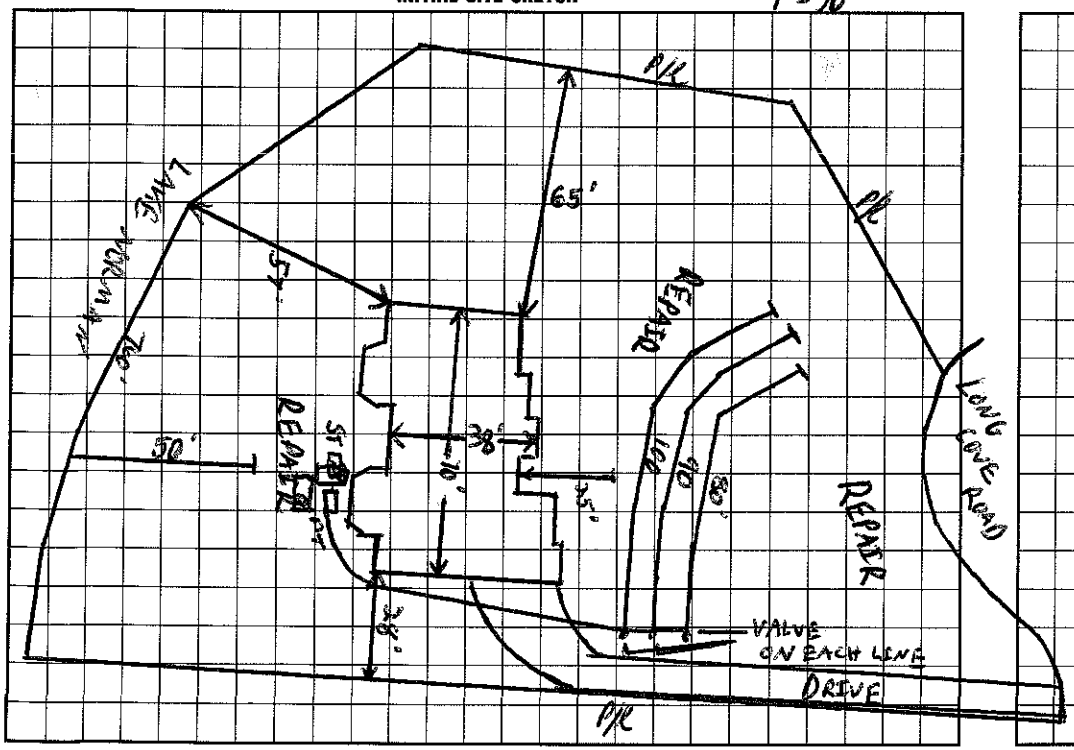

AS BUILT SKETCH

I understand that this permit can be suspended or revoked if any false information is supplied toward securing the permit/any unauthorized changes are made to the site/any unauthorized changes are made in the installation of the system. Improvement Permit with plat valid without expiration. Improvement Permit with site plan valid for sixty months. Authorization to Construct is valid for a period equal to that of Improvement Permit – not to exceed sixty months.

Signed: Robert Lo Smith date 2/6/98

Improvement Permit by: C. Bob Keen RS date 2/4/98

Authorization to Construct by: C. Bob Keen RS date 2/4/98

Installed by: F J Ervin

Operation Permit by: C. Ryan RS date 6/7/99

Existing System Inspection by: date

HEALTH DEPT. COPY: WHITE INSPECTION COPY (FINAL): GREEN OWNER COPY (FINAL): YELLOW INSPECTION COPY (INITIAL): PINK OWNER COPY (INITIAL): GOLD