IREDELL COUNTY HEALTH DEPARTMENT

$50.00 paid

STATESVILLE 704-878-5305 MOORESVILLE 704-664-5281

IMPROVEMENT PERMIT / AUTHORIZATION TO CONSTRUCT / OPERATION PERMIT / EXISTING SYSTEM INSPECTION

PERMIT# 095683 PIN# 4628-70-7535 DATE 10/29/02

OWNER OR CONTRACTOR Danny Harris PHONE: Business _____ Home 704-638-2055

ADDRESS 265 Wood Duck Run Salisbury NC 28146

LOCATION 150 W, TR Long Cove, on RT

SUBDIVISION Pinnacle Shores BLOCK / SECTION 2 LOT 10 LOT AREA 0.74AC SITE CLASS PS DESIGN FLOW 480 L.T.A.R. 0.3

Septic Tank: ~~1000~~ 1500 Gallons; STB 338 Date 9/24/02

Pump Tank: _____ Gallons; PT _____ Date _____

Pump Make: _____ Model _____ Serial No. _____

Nitrification Field: No. Fields 1 Square Feet 1200 Linear Feet 400

No. Lines 4 @ 100' Trench Width 36" Max Trench Bottom Depth 36" Gravel Depth —

☒ New System ☐ Repair System Type: I, II, III, IV, V, VI

System Description: Gravity 25% Reduction

Repair System Description: LP Panel Block

Maintenance Agreement Required: ☐ Yes ☒ No

☒ House/Mod. Home ☐ Mobile Home ☐ Business ☐ Other

No. Bedrooms 4 No. Bathrooms 4.5 No. Employees _____


☐ Slab ☐ Crawl Space ☒ Basement w/plumbing ☐ Basement wo/plumbing

Water Supply: ☐ Individual ☐ Public ☒ Community


Comments:/Conditions:

Comments:/Conditions:

INITIAL SITE SKETCH

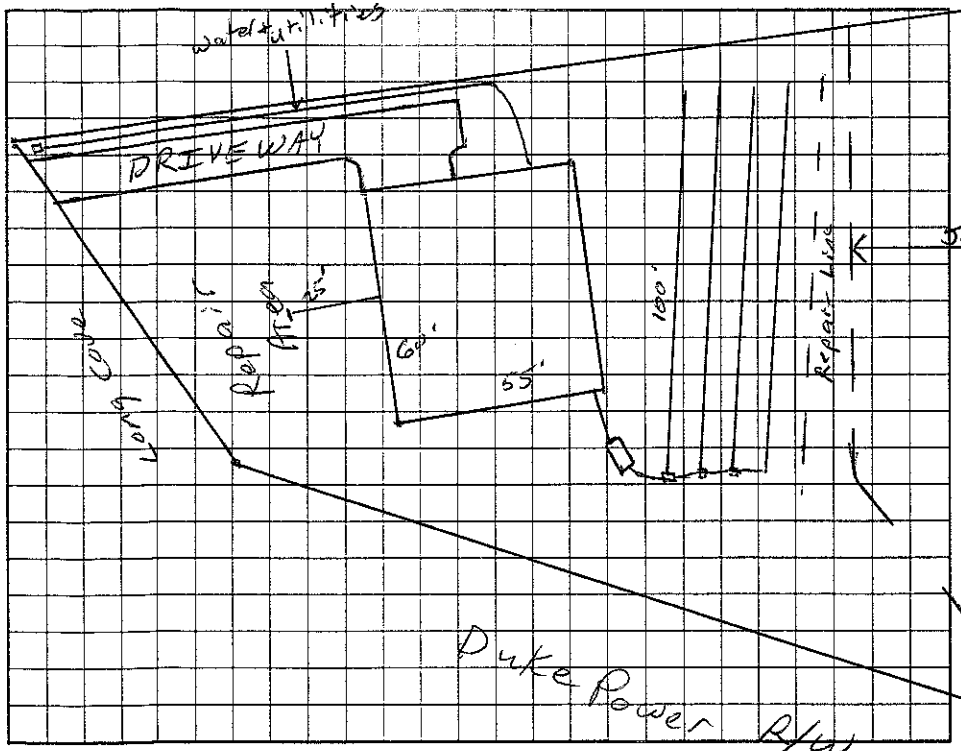

AS BUILT SKETCH

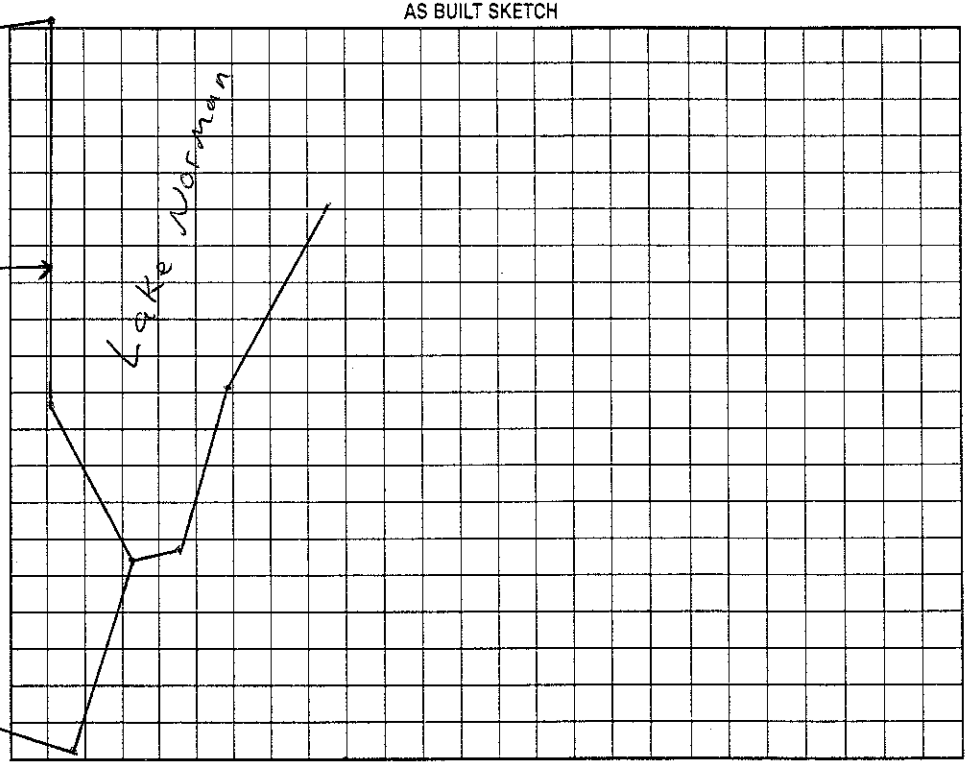

Permit can be suspended or revoked if any false information is supplied toward securing the permit/any unauthorized changes are made to the site/any unauthorized changes are made in the installation of the system. Improvement Permit with plat valid without expiration. Improvement Permit with site plan valid for sixty months. Authorization to Construct is valid for a period equal to that of Improvement Permit – not to exceed sixty months.

Signed: Steve McAlister date 10/30/02 Installed by: FJ Ervin

Improvement Permit by: RS date 10/29/02 Operation Permit by: RS date 10/30/02

Authorization to Construct by: RS date 10/29/02 Existing System Inspection by: _____ date _____

HEALTH DEPT. COPY: WHITE OWNER COPY (FINAL): YELLOW OWNER COPY (INITIAL): PINK