(9:30)

IREDELL COUNTY HEALTH DEPARTMENT

STATESVILLE 704-878-5305 MOORESVILLE 704-664-5281

IMPROVEMENT PERMIT / AUTHORIZATION TO CONSTRUCT / OPERATION PERMIT / EXISTING SYSTEM INSPECTION

PERMIT# 21938 PIN# part of 2NA20 DATE 2/4/98

OWNER OR CONTRACTOR Dayne Pierantoni PHONE: Business 664-6670 Home 4628-70-7777

ADDRESS 113 Birdie Court Mooresville, NC 28115

LOCATION Hwy 150 W TR Long Cove Rd ~ 600' on Right

SUBDIVISION Pinnacle Shores BLOCK / SECTION II LOT 8 LOT AREA 220,000 ft² SITE CLASS PS DESIGN FLOW 480gpd L.T.A.R. .3

Septic Tank: 1000 Gallons; STB 794 Date 5/22/96
Pump Tank: ____ Gallons; PT ____ Date ____
Pump Make: ____ Model ____ Serial No. ____
Nitrification Field: No Fields 1 Square Feet 1200 Linear Feet 400
No Lines 6 at 70' Trench Width 36" Max Trench Bottom Depth 36" Gravel Depth N/A

☒ New System ☐ Repair System Type: I, II, III, IV, V, VI
System Description: Gravity - Plastic Chambers Similar
Repair System Description: Pump - Modified
Maintenance Agreement Required: ☐ Yes ☒ No


☒ House/Mod. Home No. Bedrooms 4
☐ Mobile Home No. Bathrooms 4
☐ Business No. Employees ____
☐ Other ____
☐ Slab ☐ Crawl Space ☒ Basement w/plumbing ☐ Basement wo/plumbing

Water Supply: ☐ Individual ☐ Public ☒ Community


Comments:/Conditions: 25% Reduction in Drainfield Area. Keep Septic System at least 10' from Property lines & 50' from lake. (Installer May use Flow Divider & Distribution boxes instead of Drop Boxes)

Comments:/Conditions:

Scale 1:50 INITIAL SITE SKETCH

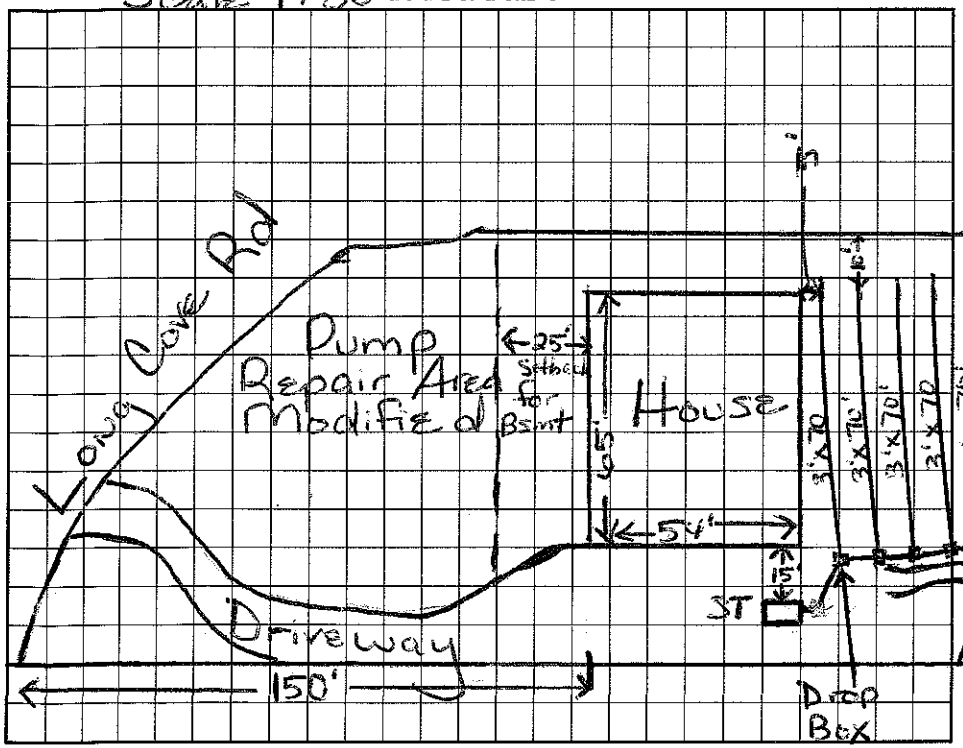

AS BUILT SKETCH

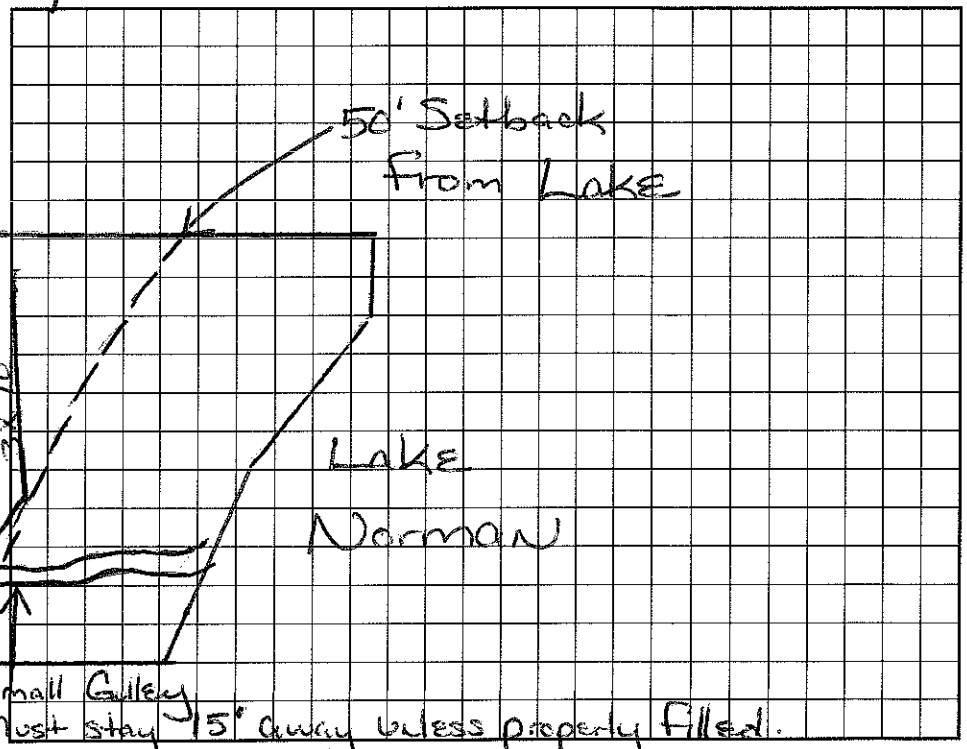

I understand that this permit can be suspended or revoked if any false information is supplied toward securing the permit/any unauthorized changes are made to the site/any unauthorized changes are made in the installation of the system. Improvement Permit with plat valid without expiration. Improvement Permit with site plan valid for sixty months. Authorization to Construct is valid for a period equal to that of Improvement Permit – not to exceed sixty months.

Signed: Dayne Pierantoni date 2/9/98
Improvement Permit by: Maria H. Dotson date 2/5/98
Authorization to Construct by: Maria H. Dotson date 2/5/98

Installed by: FJ ERVIN
Operation Permit by: [signature] date 8/20/98
Existing System Inspection by: ____ date ____

HEALTH DEPT. COPY: WHITE INSPECTION COPY (FINAL): GREEN OWNER COPY (FINAL): YELLOW INSPECTION COPY (INITIAL): PINK OWNER COPY (INITIAL): GOLD