IREDELL COUNTY HEALTH DEPARTMENT

STATESVILLE 704-878-5305 MOORESVILLE 704-664-5281

IMPROVEMENT PERMIT / CERTIFICATE OF COMPLETION / OPERATION PERMIT / EXISTING SYSTEM INSPECTION

PROPERTY DESCRIPTION NO. 21301 DATE Aug 2 '95 TAX MAP NO. part of 2NA20 4628 71 0310 Watershed: ☑ Yes ☐ No

OWNER OR CONTRACTOR Crescent Resources / Marcus L. & Carol W. Hiatt PHONE: Business _____ Home (872 - 9528)

ADDRESS PO Box 1003, Charlotte

LOCATION 150 W TR Pinnacle Shores Dr. TR Sienna Lane at end (sewer easement on left - lot 9)

SUBDIVISION Pinnacle Shores BLOCK / SECTION I LOT 5 LOT AREA .4BAC sewer easement SITE CLASS. PS per 1956 DESIGN FLOW 480 gpd L.T.A.R. .3

Septic Tank: 1000 Gallons; STB 794 Date 3/24/98

Pump Tank: 1000 Gallons; PT 47 Date 5/30/98

Pump Make: GOULDS Model _____ Serial No. _____

Nitrification Field: No Fields 1 Square Feet 1200 Linear Feet 400

No Lines 4@100' Trench Width 36" Max Trench Bottom Depth 36" Gravel Depth N/A

☑ New System ☐ Repair System Type: I, II, (III), IV, V, VI

System Description: pumped INFILTRATOR - pm.

Repair System Description: LPPPBPS

Maintenance Agreement Required: ☐ Yes ☑ No INITIAL SYS

☑ House/Mod. Home No. Bedrooms 4

☐ Mobile Home No. Bathrooms 4

☐ Business No. Employees _____

☐ Other _____

☐ Slab ☐ Crawl Space ☑ Basement w/plumbing ☐ Basement wo/plumbing


Water Supply: ☐ Individual ☑ Community ☐ Public

Comments: Drainfield to be on offsite easement (lot 9) due to space.


7-3-97 ST & PT will have to be stacked side by side in MH Shaft to meet setbacks of house & property line

Comments: DEVELOPER PERMIT Const Auth. 7-3-97 DWB

INITIAL SITE SKETCH

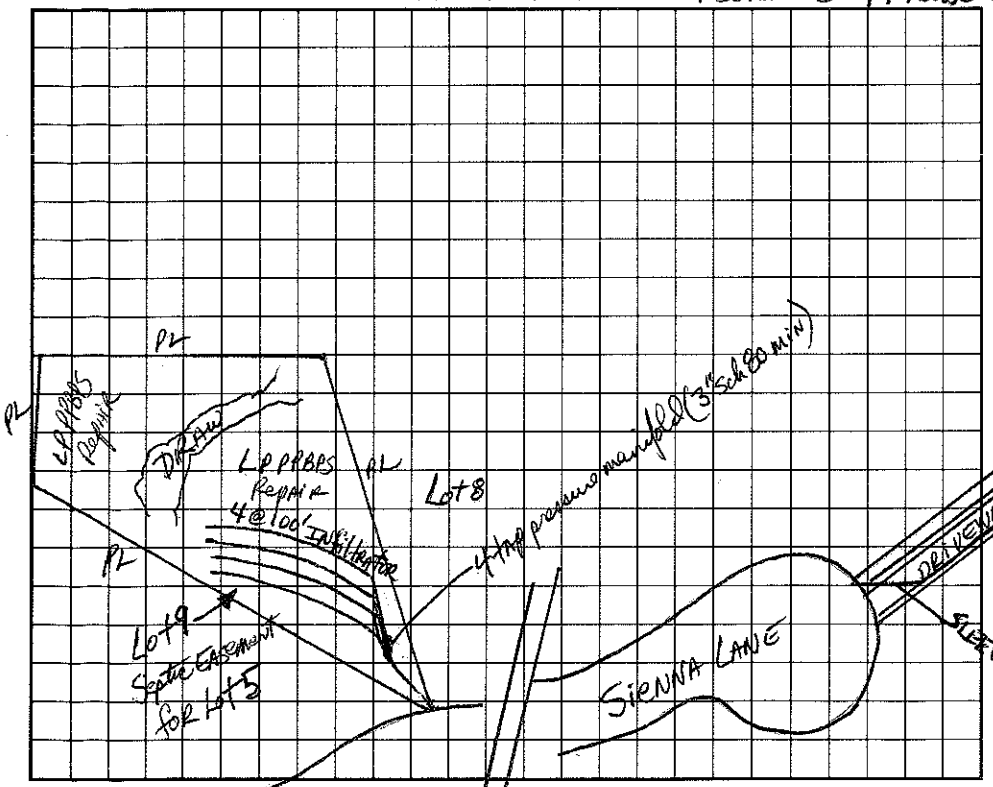

AS BUILT SKETCH

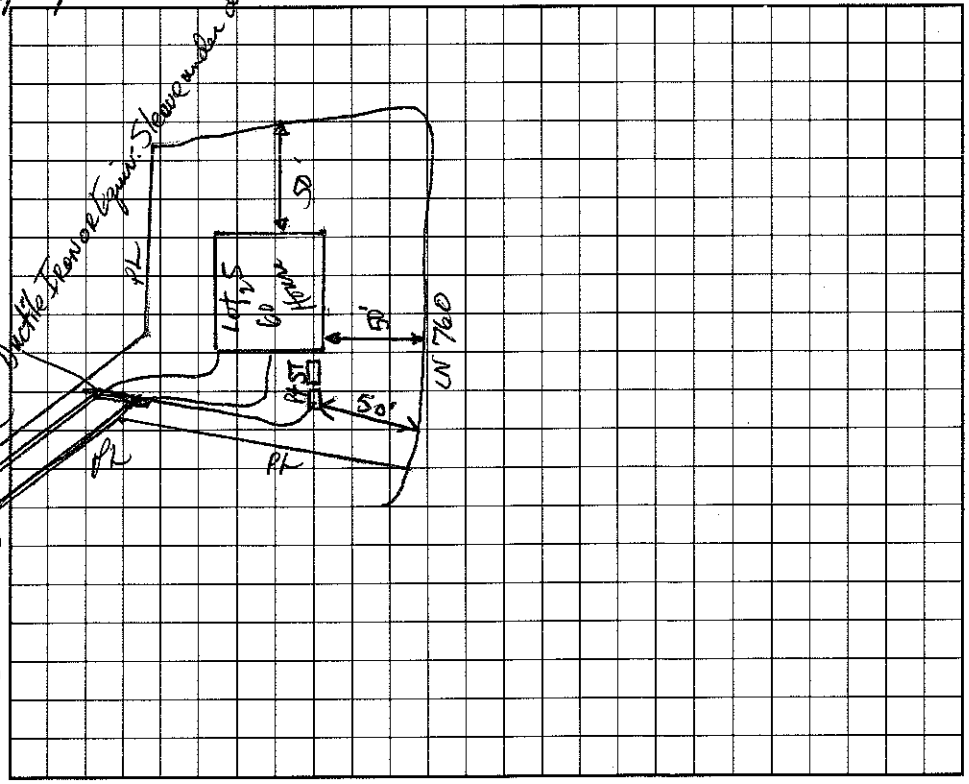

I understand that this permit can be suspended or revoked if any false information is supplied toward securing the permit/any unauthorized changes are made to the site/any unauthorized changes are made in the installation of the system.

Signed: _____

Improvement Permit by: _____ date 8-2-95

Construction / ~~Existing System Inspection~~ Authorization by: _____ date 7-3-97

Installed by: FJ Erwin

Certificate of Completion by: Wesley Sparks R.S. date 9/30/98

Operation Permit by: Wesley Sparks R.S. date 9/30/98

HEALTH DEPT. COPY: WHITE INSPECTION COPY (FINAL): GREEN OWNER COPY (FINAL): YELLOW INSPECTION COPY (INITIAL): PINK OWNER COPY (INITIAL): GOLD