IREDELL COUNTY HEALTH DEPARTMENT

STATESVILLE 704-878-5305 MOORESVILLE 704-664-5281

IMPROVEMENT PERMIT / CERTIFICATE OF COMPLETION / OPERATION PERMIT / EXISTING SYSTEM INSPECTION

PROPERTY DESCRIPTION NO. 21919 DATE 9/12/95 TAX MAP NO. 2NA 20 pt of 4628 71 0843 Watershed: [X] Yes [ ] No

OWNER OR CONTRACTOR J D Cline PHONE: Business 483-1058 Home

ADDRESS 3125 Lakeshore Rd. S Denver, NC 28037

LOCATION Pinnacle Shores (R) third road, cul de sac, straight ahead

SUBDIVISION Pinnacle Shores BLOCK / SECTION 1 LOT 26 LOT AREA 1.1 Ac SITE CLASS. PS DESIGN FLOW 360 L.T.A.R. .35

Septic Tank: 1000 Gallons; STB 794 Date 8/6/98

Pump Tank: 1000 Gallons; PT 49 Date 8/6/98

Pump Make: Meyers Model ~~Ely~~ MA50S Serial No.

Nitrification Field: No Fields 1 Square Feet 1028 Linear Feet 180 *

No Lines 3 Trench Width 24" Max Trench Bottom Depth 32" Gravel Depth 6" SAND

[X] New System [ ] Repair System Type: I, II, [III], IV, V, VI

System Description: 16" PPBS - Pressmanifold

Repair System Description: Same

Maintenance Agreement Required: [X] Yes [ ] No 3/4

[X] House/Mod. Home No. Bedrooms 3

[ ] Mobile Home No. Bathrooms 3

[ ] Business No. Employees

[ ] Other

[ ] Slab [ ] Crawl Space [X] Basement w/plumbing [ ] Basement wo/plumbing

Water Supply: [ ] Individual [X] Community [ ] Public


Comments:

* 50% reduction for Prefabricated Panels used. (1" = 40')


Comments:

41 Panels

INITIAL SITE SKETCH

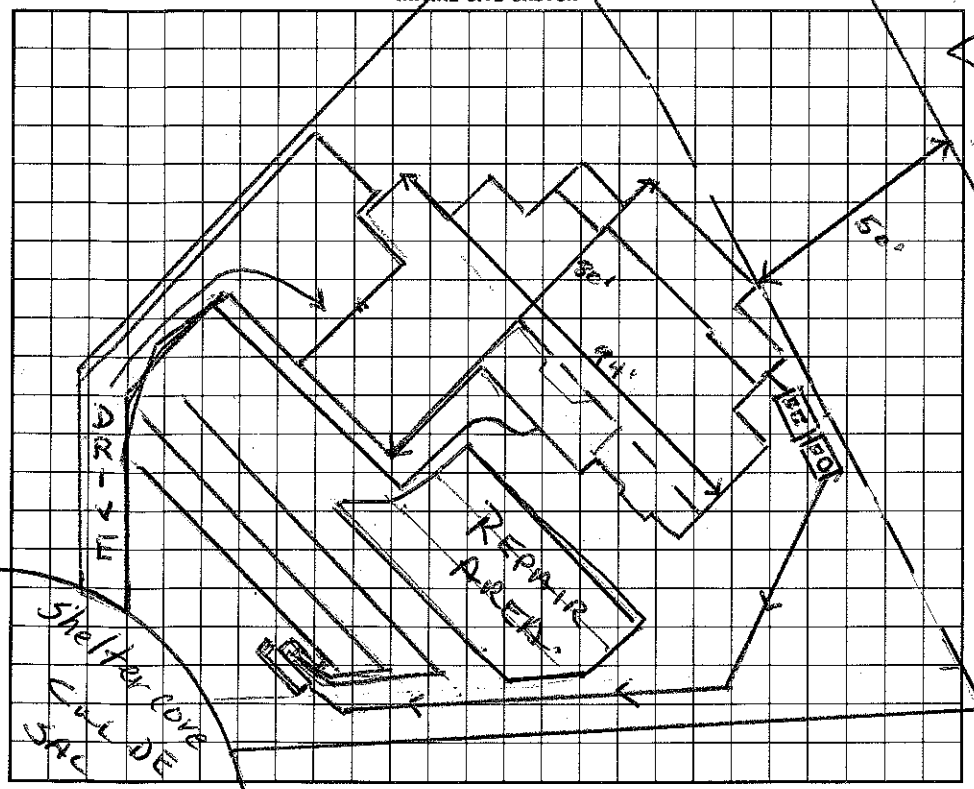

AS BUILT SKETCH

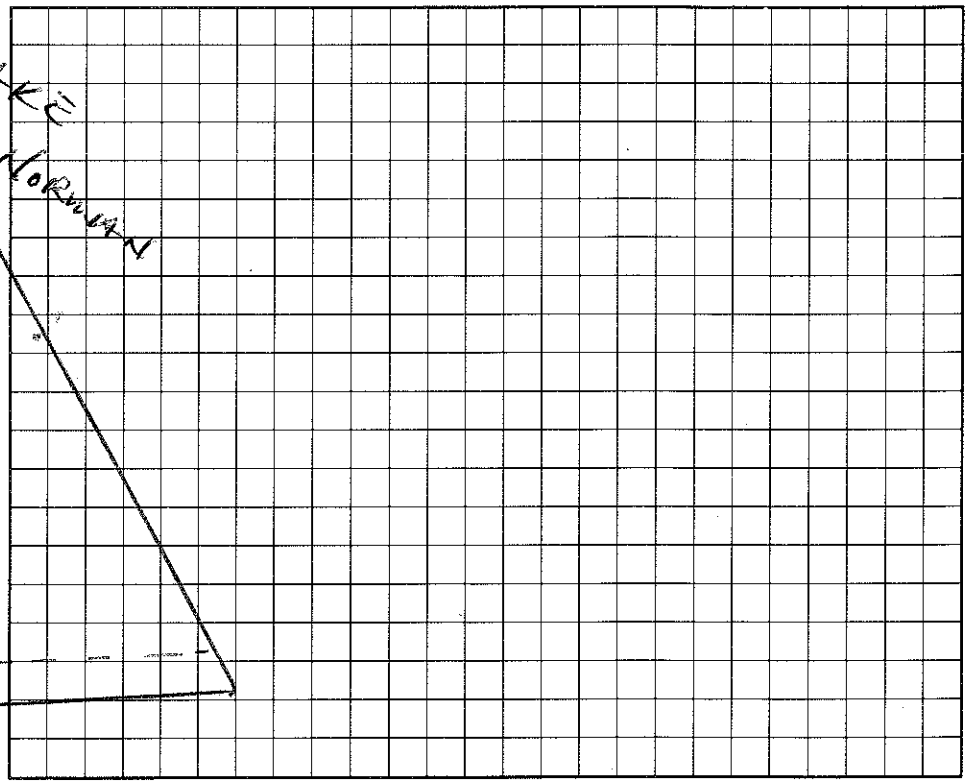

I understand that this permit can be suspended or revoked if any false information is supplied toward securing the permit/any unauthorized changes are made to the site/any unauthorized changes are made in the installation of the system.

Signed: Elizabeth R Cline

Improvement Permit by: Wesley Sparks RS. date 9/12/95

Existing System Inspection by: date

Installed by: Roddy Long

Certificate of Completion by: date

Operation Permit by: Wesley Sparks RS. date 10/29/98

HEALTH DEPT. COPY: WHITE INSPECTION COPY (FINAL): GREEN OWNER COPY (FINAL): YELLOW INSPECTION COPY (INITIAL): PINK OWNER COPY (INITIAL): GOLD