IREDELL COUNTY HEALTH DEPARTMENT

STATESVILLE 704-878-5305 MOORESVILLE 704-664-5281

IMPROVEMENT PERMIT / AUTHORIZATION TO CONSTRUCT / OPERATION PERMIT / EXISTING SYSTEM INSPECTION

130.00 Paid

PERMIT# 125076 PIN# 4628-71-7153 DATE 12/20/04

OWNER OR CONTRACTOR ~~Fenton Young~~ L. C. Dellinger Bldg. Co. PHONE: Business 704-822-1573 Home

ADDRESS ~~19 Pete Ln Unit Catawba Ave Catawba NC 28609~~ 1633 South Hwy 16 Stanley 28164

LOCATION HWY 150 W, TR Long Cove Ln, at End

SUBDIVISION Pinnacle Shores BLOCK / SECTION 3 LOT 6 LOT AREA 1.53AC + .58AC SITE CLASS. PS DESIGN FLOW 480 L.T.A.R. 0.3

Septic Tank: ~~Concrete~~ 1250 Gallons; STB W1250 Date 4732

Pump Tank: ~~Concrete~~ 1250 Gallons; PTW 1250 Date 4732

Pump Make: Goulds Model WE1512HU Serial No.

Nitrification Field: No Fields 1 Square Feet 1200 Linear Feet 400

No Lines ~~40~~ 16 Trench Width 36" Max Trench Bottom Depth 30" Gravel Depth —

☒ New System ☐ Repair System Type: I, II, (III), IV, V, VI

System Description: PM 25% Reduction

Repair System Description: LP Panel Block

Maintenance Agreement Required: ☐ Yes ☒ No

☒ House/Mod. Home ☐ Mobile Home ☐ Business ☐ Other

No. Bedrooms 4 No. Bathrooms No. Employees

Water Supply: ☐ Individual ☐ Public ☒ Community

☐ Slab ☒ Crawl Space ☐ Basement w/plumbing ☐ Basement wo/plumbing

Comments:/Conditions: Drainlines Checked by WS 11/6/09
Tanks checked RA 12/17/09

Comments:/Conditions: 6/5/09 Plans submitted, 3rd floor office needs a wall separating Masterbath to not be considered a bedroom - checks this during inspection. sc
Aquaworx 3 inches drawdown in 1mn.

GOULDS PUMPS


WE1512HU

SUBMERSIBLE PUMP

1.5HP 1/60/230 4.56" 15.7MA

ITT *Engineered for life*

AS BUILT SKETCH

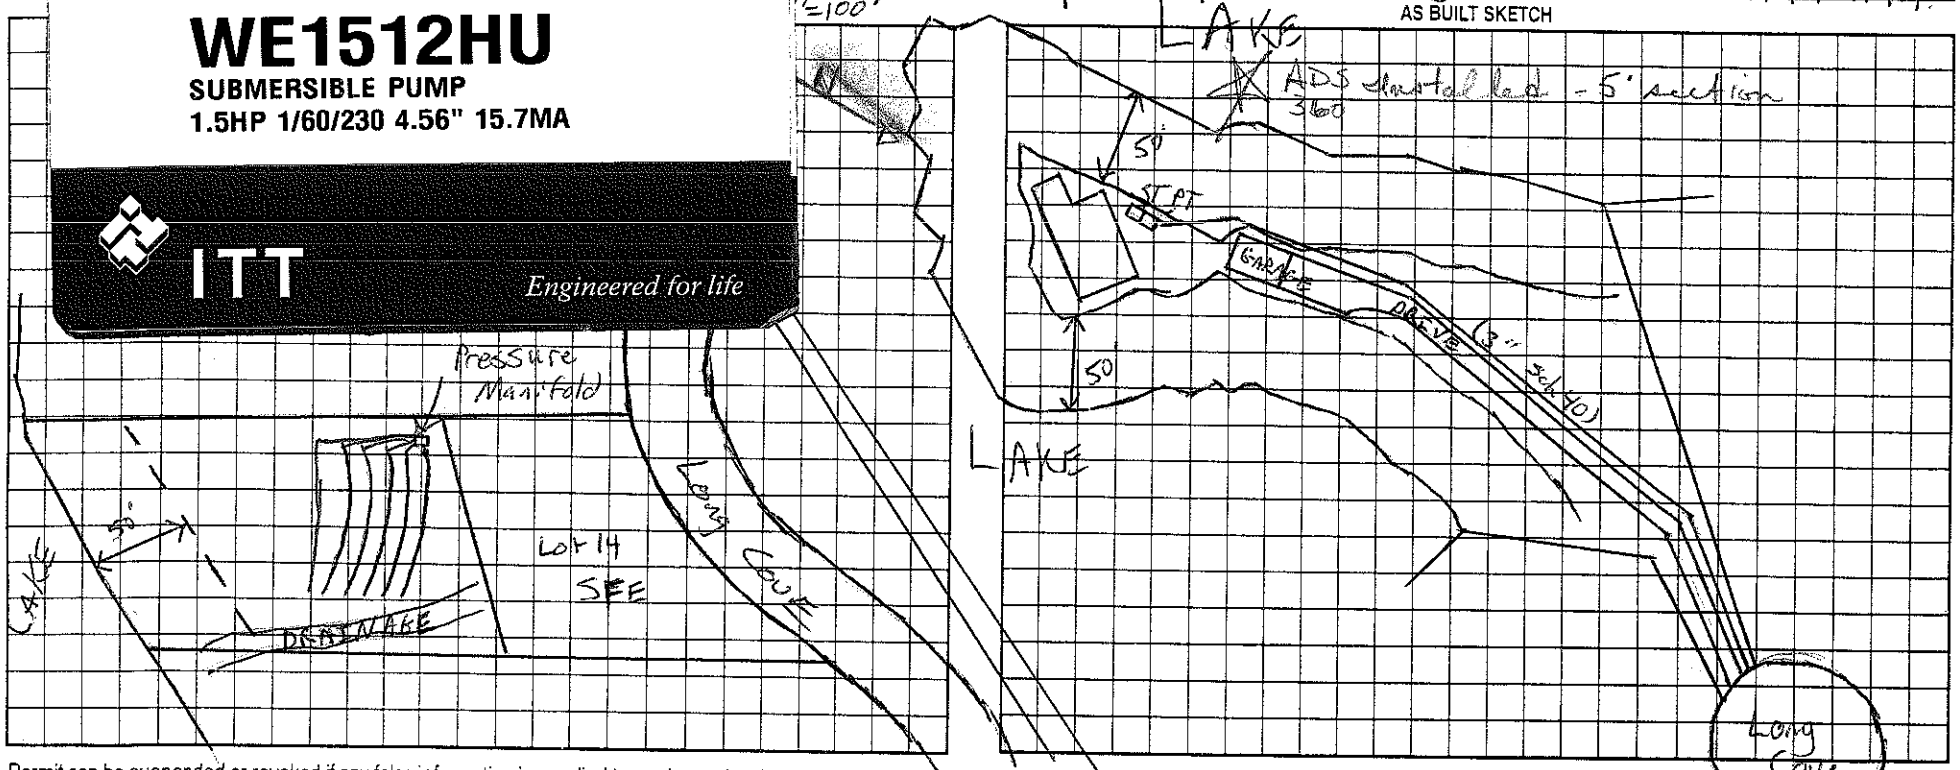

Permit can be suspended or revoked if any false information is supplied toward securing the permit/any unauthorized changes are made to the site/any unauthorized changes are made in the installation of the system. Improvement Permit with plat valid without expiration. Improvement Permit with site plan valid for sixty months. Authorization to Construct is valid for a period equal to that of Improvement Permit – not to exceed sixty months.

Signed: Geana Young date 12/20/04 Installed by: Larry Hinkle

Improvement Permit by: RS date 12/20/04 Operation Permit by: Maria H. Dotson RS date 1/22/2010

Authorization to Construct by: Anthony Coker Jr. R.S. date 6/5/09 Existing System Inspection by: date

HEALTH DEPT. COPY: WHITE OWNER COPY (FINAL): YELLOW OWNER COPY (INITIAL): PINK