IREDELL COUNTY HEALTH DEPARTMENT

STATESVILLE 704-878-5305 MOORESVILLE 704-664-5581

IMPROVEMENT PERMIT / AUTHORIZATION TO CONSTRUCT / OPERATION PERMIT / EXISTING SYSTEM INSPECTION

PERMIT# 24958 PIN# ~~2N 8A 28~~ 4628-72-0004 DATE 1/21/99

OWNER OR CONTRACTOR Randy Kidd PHONE: Business 578-3789 Home

ADDRESS 7401 Mariner Cove Drive, Cornelius 28031

LOCATION Shelter Cove Ln. 150' W TR Pinnacle Shores Dr. TR Shelter Cove Lane on (L) of cul de sac

SUBDIVISION Pinnacle Shores BLOCK / SECTION 1 LOT 28 LOT AREA .59Ac SITE CLASS. PS DESIGN FLOW 480 L.T.A.R. .3

Septic Tank: 1000 Gallons; STB 794 Date 10/1/98
Pump Tank: 1000 Gallons; PT 27 Date 10/1/98
Pump Make: HYDROMATIC Model SHEF100A1 Serial No. 11/98
Nitrification Field: No Fields 1 Square Feet 800* Linear Feet 267'*
No Lines X5 Trench Width 36" Max Trench Bottom Depth 36" Gravel Depth SAND

X New System ☐ Repair System Type: I, II, III, (IV) V, VI
System Description: Pressure – 16" PPBS *
Repair System Description: Same
Maintenance Agreement Required: X Yes ☐ No


X House/Mod. Home No. Bedrooms 4
☐ Mobile Home No. Bathrooms 4
☐ Business No. Employees
☐ Other
☐ Slab ☐ Crawl Space X Basement w/plumbing ☐ Basement wo/plumbing

Water Supply: ☐ Individual ☐ Public X Community


Comments:/Conditions: 3/16" hole per panel – turned up
50% reduction given for PPBS use
Effluent filter and Risers are required
*5 leave under driveway area

Comments:/Conditions:

INITIAL SITE SKETCH

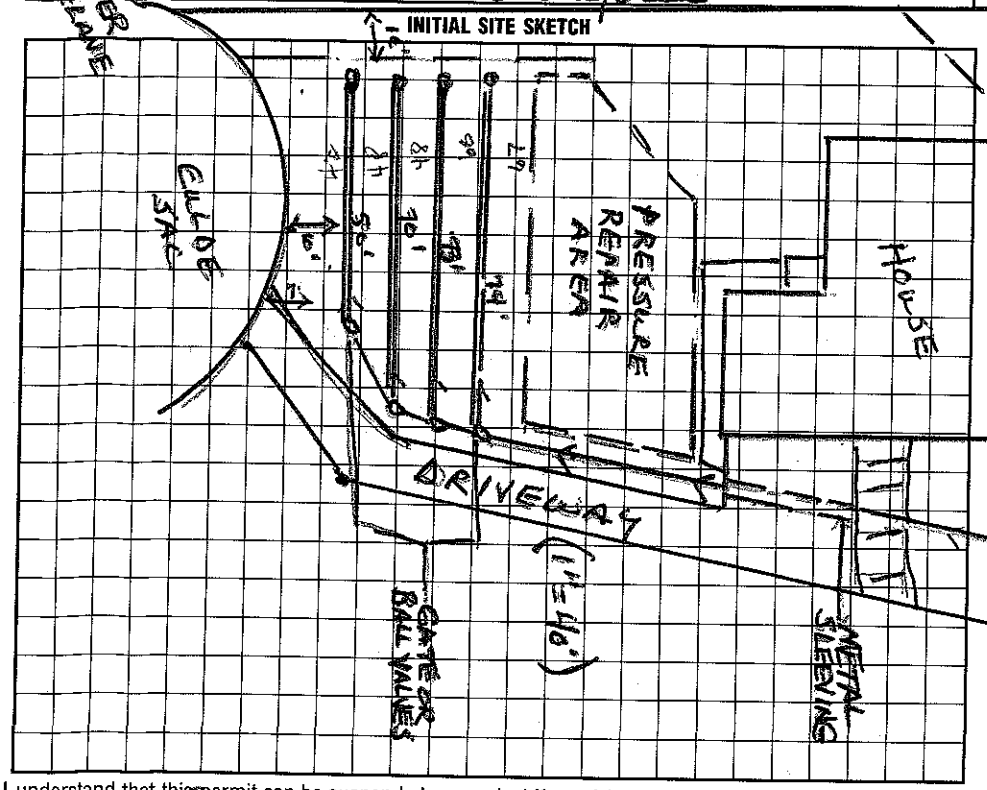

AS BUILT SKETCH

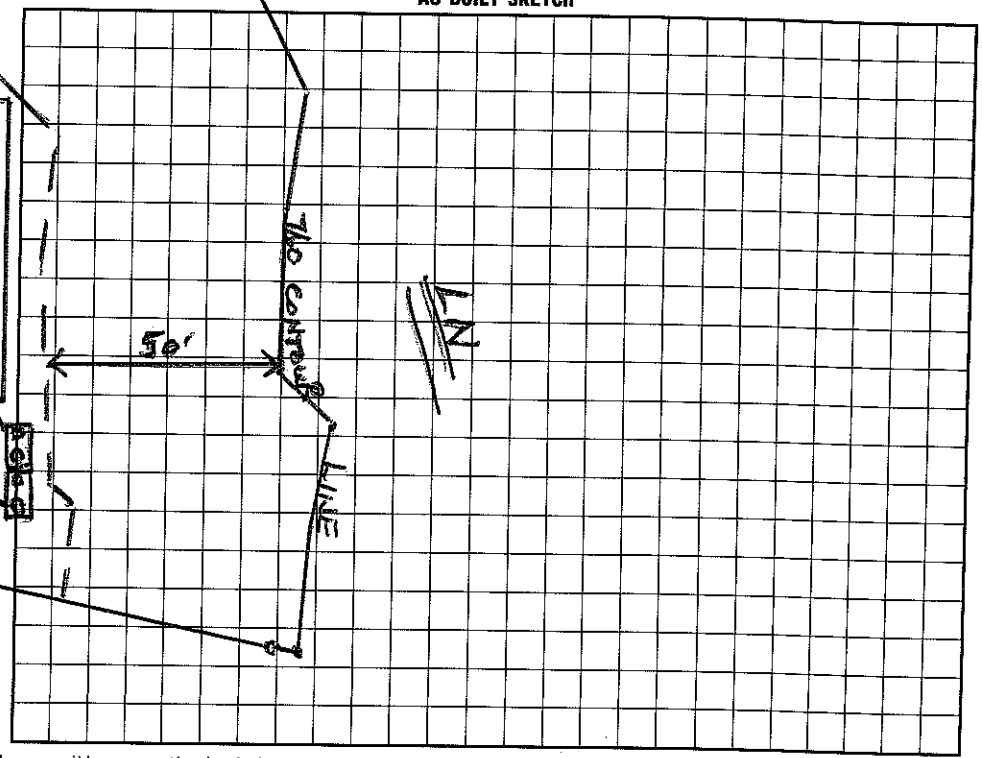

I understand that this permit can be suspended or revoked if any false information is supplied toward securing the permit/any unauthorized changes are made to the site/any unauthorized changes are made in the installation of the system. Improvement Permit with plat valid without expiration. Improvement Permit with site plan valid for sixty months. Authorization to Construct is valid for a period equal to that of Improvement Permit – not to exceed sixty months.

Signed: X Randy Kidd 1/22/99 date

Improvement Permit by: Wesley Sparks RS. date 1/21/99

Authorization to Construct by: Wesley Sparks RS date 1/21/99

Installed by: MACLEOD CONST.

Operation Permit by: Wesley Sparks RS. date 4/6/99

Existing System Inspection by: date

HEALTH DEPT. COPY: WHITE INSPECTION COPY (FINAL): GREEN OWNER COPY (FINAL): YELLOW INSPECTION COPY (INITIAL): PINK OWNER COPY (INITIAL): GOLD