IREDELL COUNTY HEALTH DEPARTMENT

Authorization to Construct

STATESVILLE 704-878-5305 MOORESVILLE 704-664-5281

IMPROVEMENT PERMIT / ~~CERTIFICATE OF COMPLETION~~ / OPERATION PERMIT / EXISTING SYSTEM INSPECTION

PROPERTY DESCRIPTION NO. 21316 DATE 2/6/96 TAX MAP NO. pt of 2NA20 4628 72 0961 Watershed: [X] Yes [ ] No

OWNER OR CONTRACTOR Bill Goodwin PHONE: Business 366-1628 Home

ADDRESS 6400 Fairview Rd. Charlotte, NC.

LOCATION 150 W TR Pinnacle Shores Dr. TR Emerald Pt Lane at end on (R) of cul de sac

SUBDIVISION Pinnacle Shores BLOCK / SECTION I LOT 39 LOT AREA 21780 SITE CLASS. PSP&I 1996 DESIGN FLOW 360 L.T.A.R. .3

Septic Tank: 1000 Gallons; STB 794 Date 8/27/96

Pump Tank: 1000 Gallons; PT 27 Date 9/30/96

Pump Make: Model Serial No.

Nitrification Field: No Fields 1 Square Feet 1200 Linear Feet * 210

No Lines 3 Trench Width 24" Max Trench Bottom Depth 36" Gravel Depth 6" SAND

[X] New System [ ] Repair System Type: I, II, (III), IV, V, VI

System Description: Press Manifold to 16" Panels

Repair System Description: Same

Maintenance Agreement Required: [ ] Yes [X] No

[X] House/Mod. Home No. Bedrooms 3

[ ] Mobile Home No. Bathrooms 3

[ ] Business No. Employees

[ ] Other


[ ] Slab [ ] Crawl Space [X] Basement w/plumbing [ ] Basement wo/plumbing

Water Supply: [ ] Individual [X] Community [ ] Public


Comments: * 50% reduction for panel use

Comments: 2@40 2@65' 130 80 80 65 11/1/96 pressure check - electrical locking

INITIAL SITE SKETCH

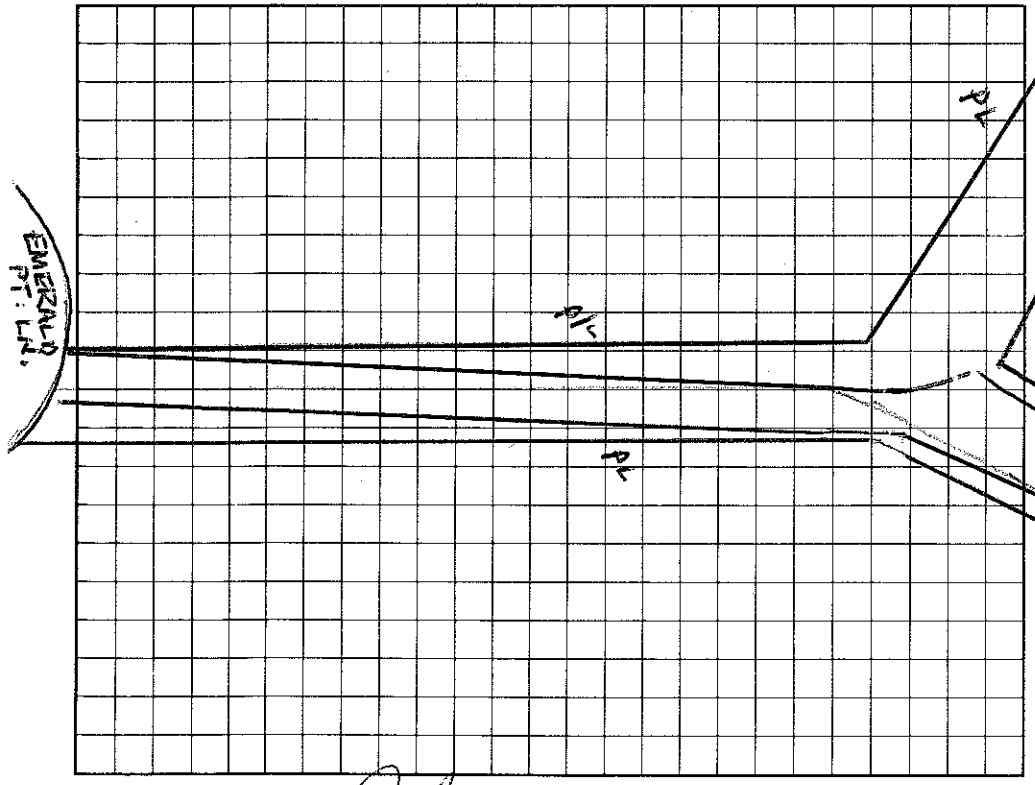

AS BUILT SKETCH

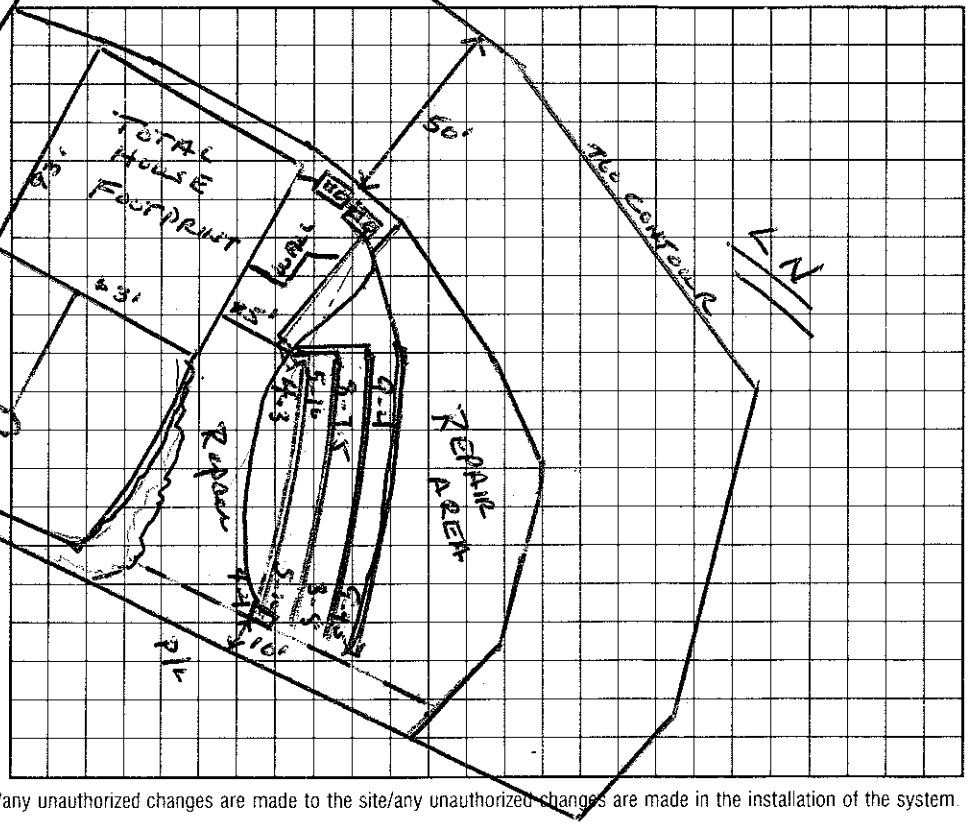

I understand that this permit can be suspended or revoked if any false information is supplied toward securing the permit/any unauthorized changes are made to the site/any unauthorized changes are made in the installation of the system.

Signed: Lee Lewis

Improvement Permit by: Wesley Sparks RS. date 2/7/96

Existing System Inspection by: Wesley Sparks RS. date 2/7/96

Installed by: F J Erwin

Certificate of Completion by: Wesley Sparks RS. date 3/3/97

Operation Permit by: Wesley Sparks RS. date 3/3/97

HEALTH DEPT. COPY: WHITE INSPECTION COPY (FINAL): GREEN OWNER COPY (FINAL): YELLOW INSPECTION COPY (INITIAL): PINK OWNER COPY (INITIAL): GOLD