(10100)

IREDELL COUNTY HEALTH DEPARTMENT

STATESVILLE 704-878-5305 MOORESVILLE 704-664-5281

IMPROVEMENT PERMIT / AUTHORIZATION TO CONSTRUCT / OPERATION PERMIT / EXISTING SYSTEM INSPECTION

PERMIT# 21942 PIN# part of 2NA20 4628 80 1509 DATE Sept. 4, '98

OWNER OR CONTRACTOR Mike Wellons PHONE: Business 333-5152 Home

ADDRESS 1660S-B Redcliff Dr. Huntersville 28078

LOCATION Hwy 150 W. TR Indigo Lane AT END

SUBDIVISION Pinnacle Shores BLOCK / SECTION II LOT 13 LOT AREA .8Ac + N12,400 ft² SFE SFE CLASS. PS DESIGN FLOW 480 gpd L.T.A.R. .3

Septic Tank: 1000 Gallons; STB 714 Date 4-25-99

Pump Tank: 1000 Gallons; PT 27 Date 5-3-99

Pump Make: Model Serial No.

Nitrification Field: No Fields 1 Square Feet 1200 Linear Feet 400

No Lines 3@134' Trench Width 36" Max Trench Bottom Depth 36" Gravel Depth NA

☑ New System ☐ Repair System Type: I, II, III, IV, V, VI

System Description: pumped-pm-25% Reduction on Easement

Repair System Description: SAME

Maintenance Agreement Required: ☐ Yes ☑ No

☑ House/Mod. Home No. Bedrooms 4

☐ Mobile Home No. Bathrooms 4

☐ Business No. Employees

☐ Other

☐ Slab ☐ Crawl Space ☑ Basement w/plumbing ☐ Basement wo/plumbing


Water Supply: ☐ Individual ☑ Public ☑ Community

Comments:/Conditions: Septic Field Easement must be properly recorded at Register of Deeds prior to issuance of septic Operation Permit. Copy of this to be supplied to Health Dept. Final surveyed plat indicating supply line Route and copy of DOT Easement must be provided also.


Comments:/Conditions: Pump: 1½ H.P. WC 15/2 HH C971606D Gould5

INITIAL SITE SKETCH

NOT to Scale

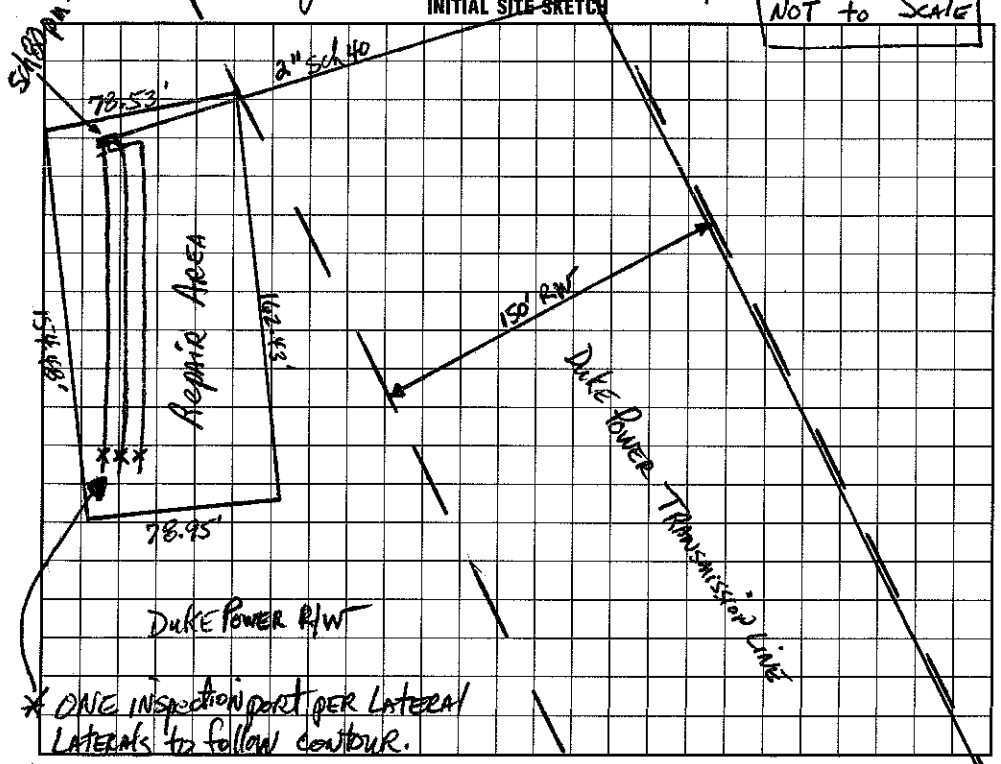

AS BUILT SKETCH

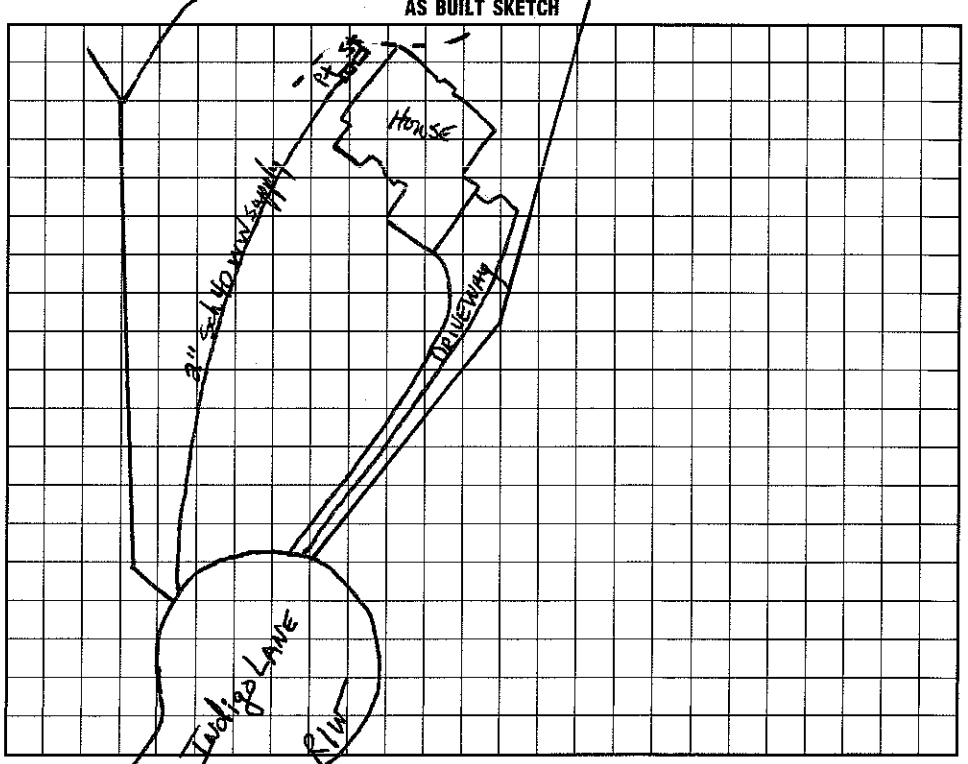

I understand that this permit can be suspended or revoked if any false information is supplied toward securing the permit/any unauthorized changes are made to the site/any unauthorized changes are made in the installation of the system. Improvement Permit with plat valid without expiration. Improvement Permit with site plan valid for sixty months. Authorization to Construct is valid for a period equal to that of Improvement Permit – not to exceed sixty months.

Signed: Mike Wellons date 9-4-98 Installed by: FJ Erving

Improvement Permit by: DR Jamison, RS date 9-4-98 Operation Permit by: LOH Moyer date 7/14/99

Authorization to Construct by: DR Jamison, RS date 9-4-98 Existing System Inspection by: date

HEALTH DEPT. COPY: WHITE INSPECTION COPY (FINAL): GREEN OWNER COPY (FINAL): YELLOW INSPECTION COPY (INITIAL): PINK OWNER COPY (INITIAL): GOLD