# IREDELL COUNTY HEALTH DEPARTMENT

STATESVILLE 704-878-5305 MOORESVILLE 704-664-5281

## IMPROVEMENT PERMIT / AUTHORIZATION TO CONSTRUCT / OPERATION PERMIT / EXISTING SYSTEM INSPECTION

PERMIT# No PIN# 4628 80 7437 DATE 7/5/06

OWNER OR APPLICANT F J Mullally PHONE: Business 704-663-0372 Home

ADDRESS 147 Waddell Rd. Mooresville, NC 28117

LOCATION Waddell Rd, 150 W TR Waddell Rd ~.2 miles (L) to end of drive on (R)

SUBDIVISION C L + T BLOCK / SECTION 11 LOT 317 LOT AREA ~.9 Ac SITE CLASS. PS DESIGN FLOW 360 L.T.A.R. .3

Septic Tank: Gallons: STB Date

Pump Tank: 1000 Gallons: PT 530 Date

Pump Make Zoeller Model EXISTING Wed. Serial No.

Nitrification Field: No Fields Square Feet 420 Linear Feet 210

No Lines 3' Trench Width 2' Max Trench Bottom Depth 3'

☐ New System ☒ Repair ☐ Expansion System Type: I II III (IV) V VI

System Description:

Repair System Description: Type 4 - 16" PPBRS

Maintenance Agreement Required: ☒ Yes ☐ No

Gravel Depth No ☐ Gravity ☒ Pressure ☒ Slab ☐ Crawl Space ☒ Basement w/plumbing ☐ Basement wo/plumbing

☒ House/Mod. Home No. Bedrooms 3

☐ Mobile Home No. Persons

☐ Business No. Employees

☐ Other


Water Supply: ☒ Individual ☐ Public ☐ Community

Comments:/Conditions: MARLIN TAN CONTAINER CORP.

Comments:/Conditions: Area above drive could be used for Type 4 - 16" PPBRS - 210 feet total length PS - Soil Material Found w/ Backhoe Pit

INITIAL SITE SKETCH

AS BUILT SKETCH

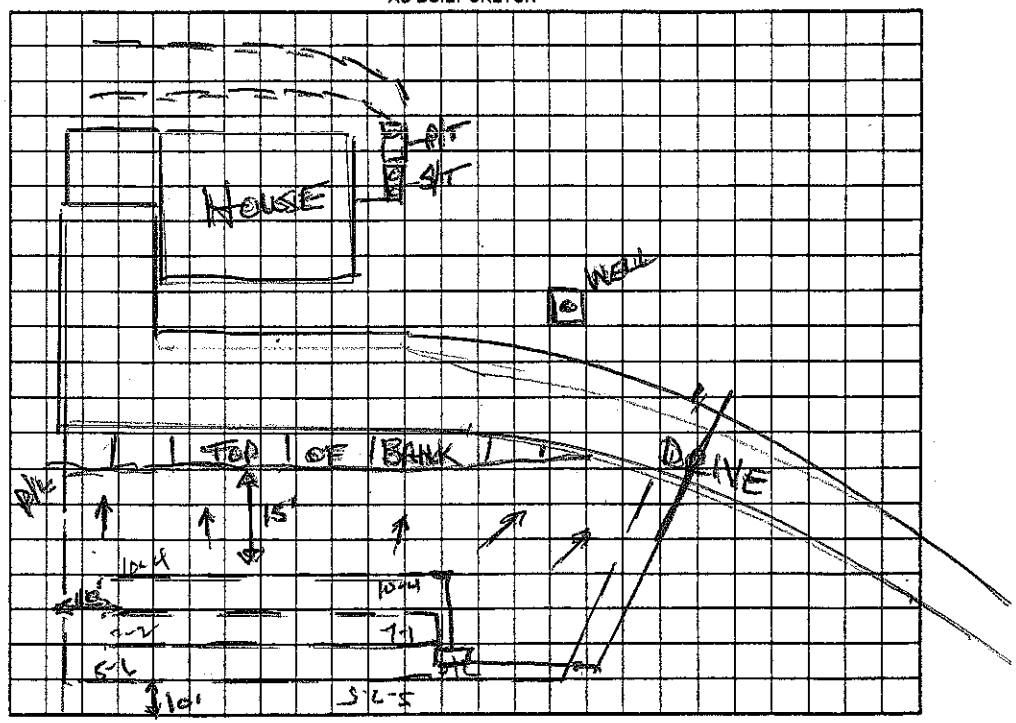


Permit can be suspended or revoked if any false information is supplied toward securing the permit/any unauthorized changes are made to the site/any unauthorized changes are made in the installation of the system. Improvement Permit with plat valid without expiration ☐ Improvement Permit with site plan valid for sixty months ☐ Authorization to Construct is valid for a period equal to that of Improvement Permit – not to exceed sixty months.

Signed: F J Mullally date

Improvement Permit by: Wesley Sparks RS date 7/5/06

Authorization to Construct by: Wesley Sparks RS date 7/5/06

Installed by: F J Erwin

Operation Permit by: date

Existing System Inspection by: Wesley Sparks RS. date 7/5/06

HEALTH DEPT. COPY: WHITE OWNER COPY (FINAL): YELLOW OWNER COPY (INITIAL): PINK