3'0

IREDELL COUNTY HEALTH DEPARTMENT

STATESVILLE 704-878-5305 MOORESVILLE 704-664-5281

IMPROVEMENT PERMIT / AUTHORIZATION TO CONSTRUCT / OPERATION PERMIT / EXISTING SYSTEM INSPECTION

PERMIT# 136909 PIN# 4628809454 DATE 7-28-06

OWNER OR APPLICANT Joanne Rosinski/Jeremy Michelle PHONE: Business 704-724-3751 Home

ADDRESS 514 Williamson Rd Mooresville 28117

LOCATION Hwy 150 W TR Waddell Rd on left

SUBDIVISION BLOCK / SECTION LOT LOT AREA .88 Ac SITE CLASS. PS DESIGN FLOW 480gpd L.T.A.R. .3 gpd/ft²

Septic Tank: 1000 Gallons; STB 794 Date 4-22-07
Pump Tank: Gallons; PT Date
Pump Make: Model Serial No.
Nitrification Field: No Fields 1 Square Feet 1600 Linear Feet 400
No Lines 4 @100' Trench Width 36" Max Trench Bottom Depth 36"

☑ New System ☐ Repair ☐ Expansion System Type: I II III IV V VI
System Description: 2590 reduction gravity
Repair System Description: LPPPBPS
Maintenance Agreement Required: ☐ Yes ☒ No
Gravel Depth NA ☒ Gravity ☐ Pressure

☒ House/Mod. Home No. Bedrooms 4
☐ Mobile Home No. Persons 8
☐ Business No. Employees
☐ Other


Water Supply: ☒ Individual ☐ Public ☐ Community

☐ Slab ☒ Crawl Space ☐ Basement w/plumbing ☐ Basement wo/plumbing

Comments/Conditions: For slope stability recommend keeping as many trees on lot as possible
Plant grass over trenches


Comments/Conditions: 5/29/07 Checked ST & Upper 2 lines
5/29/07 Checked Lower 2 lines

INITIAL SITE SKETCH 1" = 50'

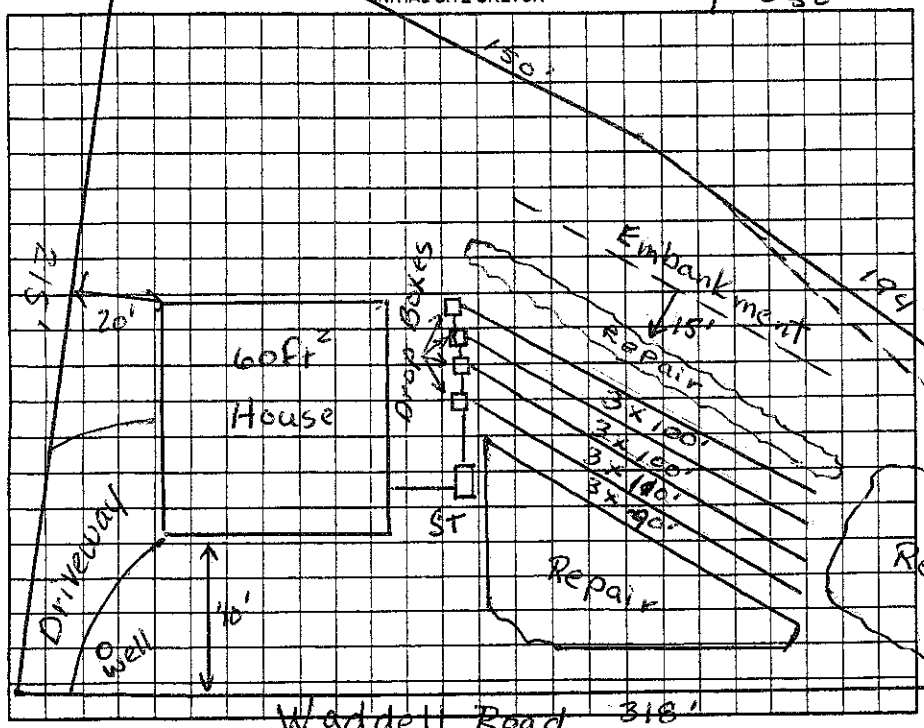

AS BUILT SKETCH

Installed E-Z Flow

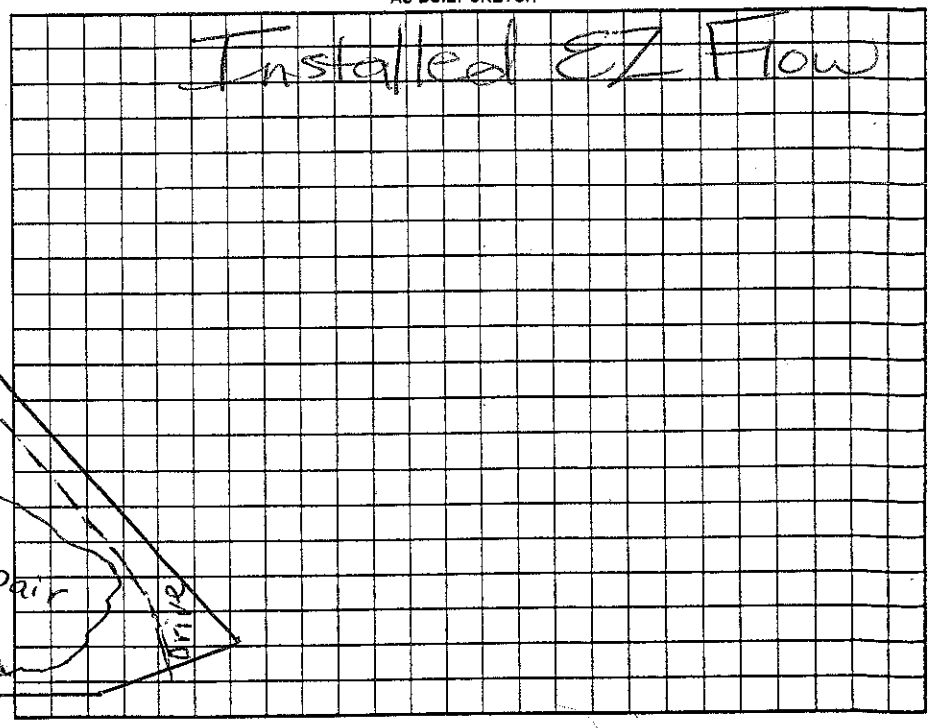

Permit can be suspended or revoked if any false information is supplied toward securing the permit/any unauthorized changes are made to the site/any unauthorized changes are made in the installation of the system. Improvement Permit with plat valid without expiration ☐ Improvement Permit with site plan valid for sixty months ☒ Authorization to Construct is valid for a period equal to that of Improvement Permit – not to exceed sixty months.

Signed: [signature] date

Improvement Permit by: Judy Melville date 8-2-06

Authorization to Construct by: Wesley Sparks RS date 10/24/06

Installed by: R. Ritchie RS

Operation Permit by: Mark H Dotson date 5/29/07

Existing System Inspection by: date

HEALTH DEPT. COPY: WHITE OWNER COPY (FINAL): YELLOW OWNER COPY (INITIAL): PINK