IREDELL COUNTY, HEALTH DEPARTMENT 4628815529

Statesville Phone TR 3-7271 Mooresville Phone NO 3-1271

PERMIT TO INSTALL SEPTIC TANK

Permit No. 136 Permit Date 9-24- 1971

Owner Claudine Morgan Address Charlotte

Installed By John Howie Address Lowesville

Location of Property 150 west to right after Gilbert 4/10 mi on right 218 Waddell


C & T II Lot 294

Tank		Capacity		Length of Lines		Fixtures	
Block	( )	1000	(✓)	225'	( )	No. of Baths	( )
Precast	(✓)	1250	( )	250'	( )	Dishwasher	( )
		1500	( )	Other 105'		Garbage Grdr.	( )
		Other				Other	

NOTIFY HEALTH DEPARTMENT AT LEAST EIGHT HOURS BEFORE TANK IS TO BE INSPECTED.

Final Inspection 9-24- 1971 Approved ( ) Disapproved ( )

Remarks This Property ~~would~~ will not permit a ~~s~~ regular installation. ~~T~~ Twice the regular amount of stone was used and lines were dug in rock. Owners responsibility

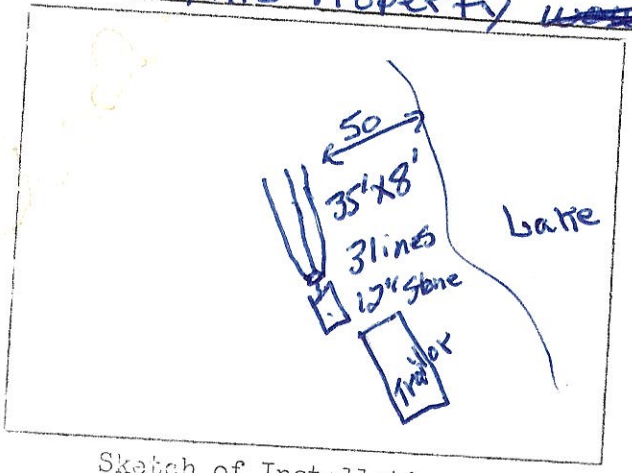

Sketch of Installation

J. C. Moore
Sanitarian