IREDELL COUNTY HEALTH DEPARTMENT

STATESVILLE 704-878-5305 MOORESVILLE 704-664-5281

IMPROVEMENT PERMIT / AUTHORIZATION TO CONSTRUCT / OPERATION PERMIT / EXISTING SYSTEM INSPECTION

PERMIT# 135215 PIN# 4628 81 ~~5517~~ 5529 DATE 5/1/06

OWNER OR APPLICANT Trevor Ashline PHONE: Business _____ Home _____

ADDRESS 115 Clover Hill Rd Mooresville NC 28117

LOCATION 150' W TR Waddell, TR Clover Hill on corner

SUBDIVISION CLAT BLOCK / SECTION 11 LOT 294 LOT AREA 1.116 AC SITE CLASS. PS DESIGN FLOW 360 L.T.A.R. —

Septic Tank: Existing Gallons: STB _____ Date _____

Pump Tank: _____ Gallons: PT _____ Date _____

Pump Make: _____ Model _____ Serial No. _____

Nitrification Field: No Fields ___ Square Feet _____ Linear Feet _____

No Lines _____ Trench Width _____ Max Trench Bottom Depth _____ Gravel Depth _____ ☐ Gravity ☐ Pressure

☐ New System ☐ Repair ☐ Expansion System Type: I II III IV V VI

System Description: Ex. Gravel Bed

Repair System Description: _____

Maintenance Agreement Required: ☐ Yes ☐ No

☒ House/Mod. Home No. Bedrooms 3

☐ Mobile Home No. Persons ___

☐ Business No. Employees ___

☐ Other _____


Water Supply: ☒ Individual ☐ Public ☐ Community

☐ Slab ☐ Crawl Space ☐ Basement w/plumbing ☐ Basement wo/plumbing


Comments:/Conditions: WATER LINE 95' NOT TO Septic

Comments:/Conditions:

INITIAL SITE SKETCH

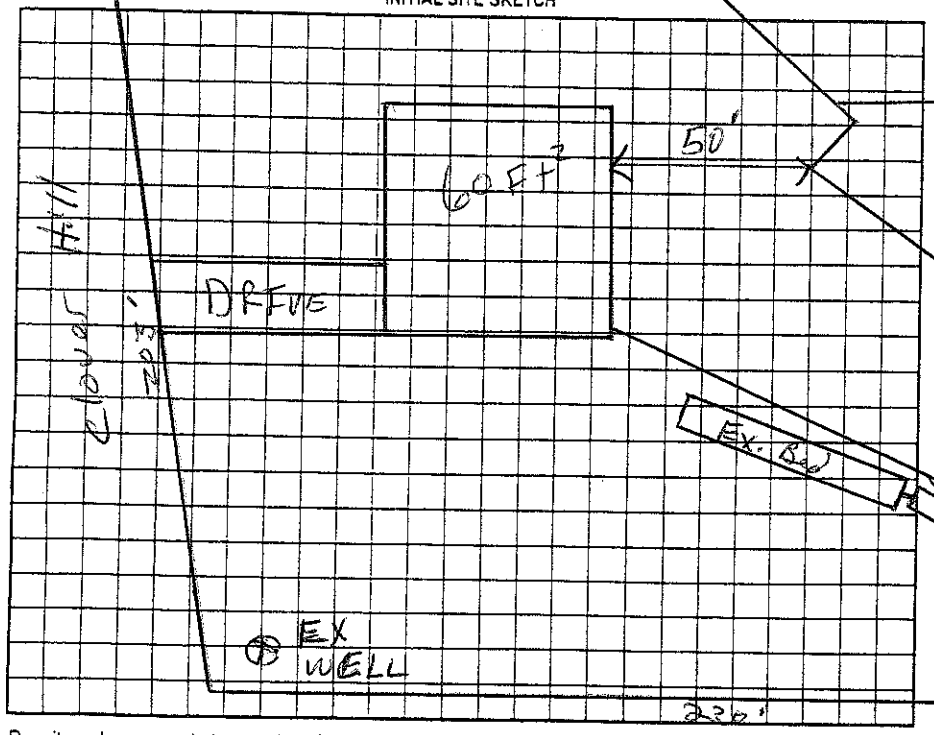

AS BUILT SKETCH

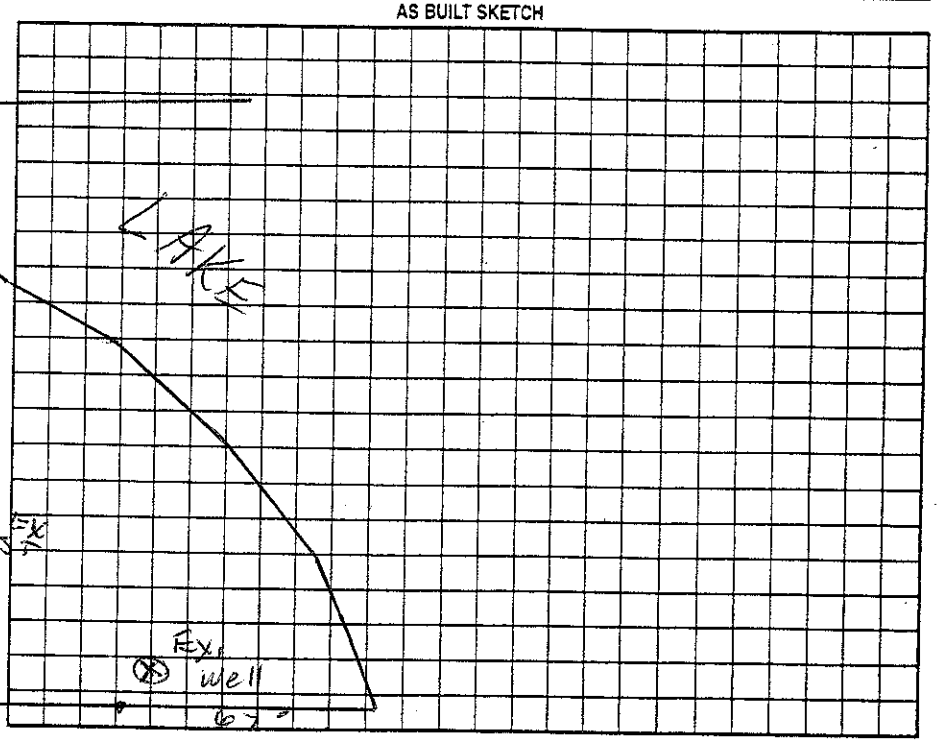

Permit can be suspended or revoked if any false information is supplied toward securing the permit/any unauthorized changes are made to the site/any unauthorized changes are made in the installation of the system. Improvement Permit with plat valid without expiration ☐ Improvement Permit with site plan valid for sixty months ☐ Authorization to Construct is valid for a period equal to that of Improvement Permit – not to exceed sixty months.

Signed: Trevor P. Ashline date 5-2-06

Improvement Permit by: _____ date _____

Authorization to Construct by: _____ date _____

Installed by: _____

Operation Permit by: _____ date _____

Existing System Inspection by: RS date 5/1/06

HEALTH DEPT. COPY: WHITE OWNER COPY (FINAL): YELLOW OWNER COPY (INITIAL): PINK