IREDELL COUNTY HEALTH DEPARTMENT

Statesville Office (704) 878-5305 Mooresville Office (704) 660-3625 PERMIT # 221739

IMPROVEMENT PERMIT / AUTHORIZATION TO CONSTRUCT / OPERATION PERMIT / EXISTING SYSTEM

PIN # 4628-81-9469

APPLICANT: TODD YOUNGBLOOD APPLICANT ADDRESS: 122 CLOVER HILL RD. MOORESVILLE

SITE ADDRESS: SAME PHONE: 704-607-6260 ALT. PHONE:

SITE DIRECTIONS: 150 W, TR WADDELL, TR CLOVER HILL, ON R

SUBDIVISION: CL&T SECTION: 11 LOT # 287 LOT AREA: DESIGN FLOW: 240 L.T.A.R.:

Septic Tank 1000 (gal) STB 2011 - 1/16 Date NO
Pump Tank (gal) PT Date
Pump Make Model Serial #
Nitrification Fields EXISTING # Lines Linear Ft:
Trench Width Max. Trench Bottom Depth Gravel Depth


☐ New System ☑ Repair ☐ Expansion System Type: I (II) III IV V VI
System Description:
Repair System Description: TANK
Maintenance Agreement Required: ☐ YES ☑ NO
☑ GRAVITY ☐ PRESSURE

☑ Residence No. Bedrooms
☐ Business No. Persons
☐ Other No. Employees
☐ Slab ☐ Crawl Space
☑ Basement w/plumbing ☐ Basement w/o plumbing


Water Supply: ☑ Private ☐ Public ☐ Community

Comments / Conditions: INFILTRATOR PLASTIC TANK INSTALLED

INITIAL SITE SKETCH

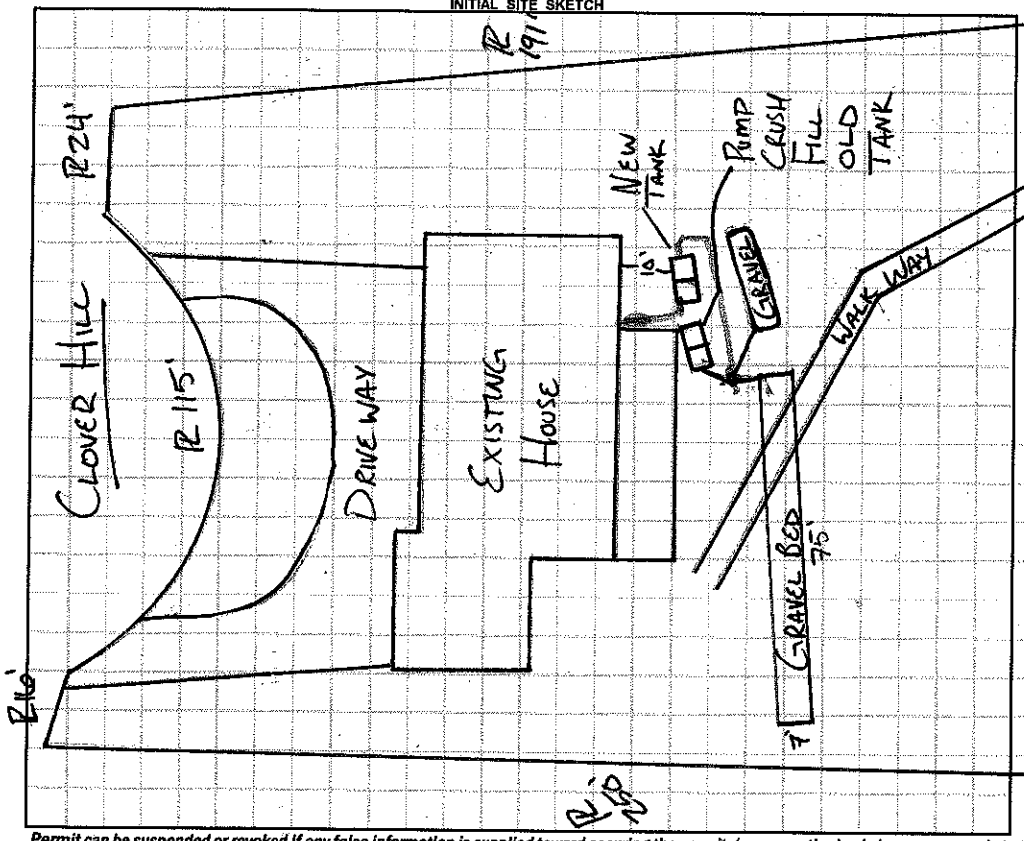

AS BUILT SKETCH

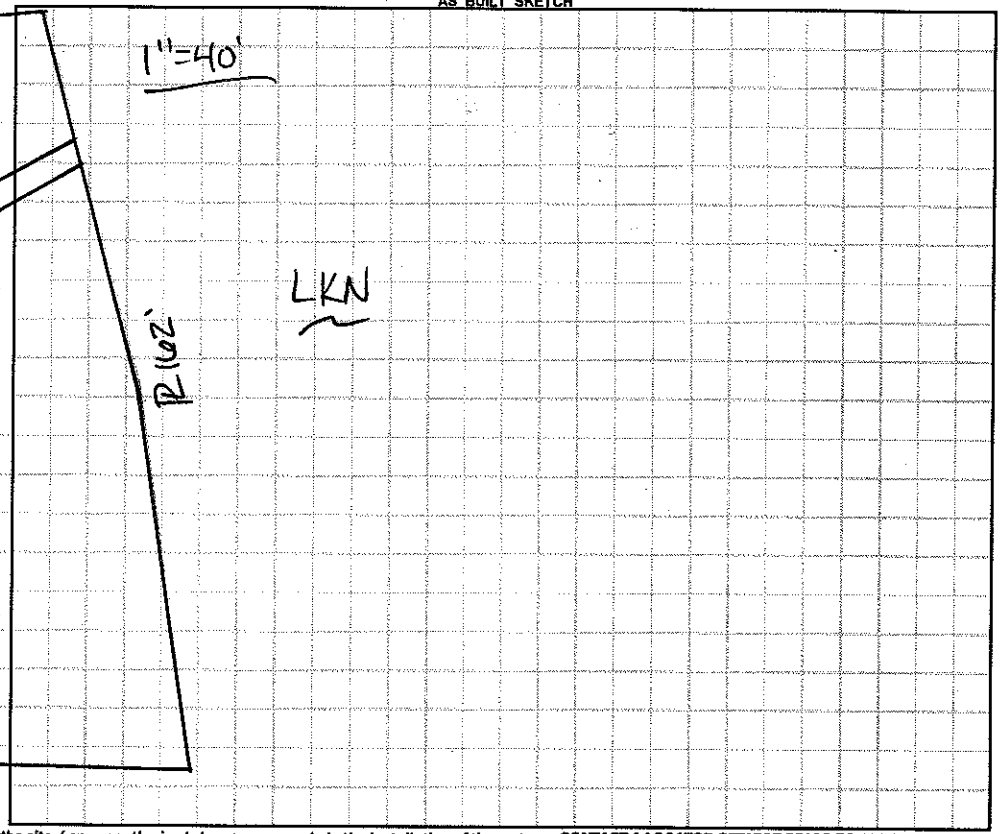

Permit can be suspended or revoked if any false information is supplied toward securing the permit / any unauthorized changes are made to the site / any unauthorized changes are made in the installation of the system. **CONTACT A LOCATOR SERVICE PRIOR TO ANY EXCAVATION**

☐ **IMPROVEMENT PERMIT** *with plat valid without expiration.* ☑ **IMPROVEMENT PERMIT** *with site plan valid for 60 mos.* ☑ **AUTHORIZATION TO CONSTRUCT** *valid for period equal to IMPROVEMENT PERMIT--not to exceed 60 mo.*

Owner / Applicant Signature: Date: 9-19-16 Installed by: Jared Lentz

IMPROVEMENT PERMIT by: Date: APPROVED SEP 15 2016 OPERATION PERMIT by: W Sparks Date: 10/17/16

AUTHORIZATION TO CONSTRUCT by: Date: APPROVED SEP 15 2016 Existing System Inspected by: Date:

Health Dept. Copy - WHITE Applicant (Final Approval) - YELLOW Applicant (Conditional Approval) - PINK