IREDELL COUNTY HEALTH DEPARTMENT

STATESVILLE 704-878-5305 125.00 Paid 11.00 MOORESVILLE 704-664-5281

IMPROVEMENT PERMIT / AUTHORIZATION TO CONSTRUCT / OPERATION PERMIT / EXISTING SYSTEM INSPECTION

PERMIT# 95078 PIN# 4628823336 DATE 4/17/01

OWNER OR CONTRACTOR Van O. Stamey PHONE: Business _____ Home 663-0938

ADDRESS 259 Waddell RD Mooresville NC 28117

LOCATION 150 w R Waddell at end

SUBDIVISION Duke Power/ICA BLOCK / SECTION 11 LOT 300 LOT AREA 0.86 AC SITE CLASS. PS DESIGN FLOW 480 L.T.A.R. 0.5

Septic Tank: ~~1000~~ 1500 Gallons; STB 1011 Date 9/1/01

Pump Tank: _____ Gallons; PT _____ Date _____

Pump Make: _____ Model _____ Serial No. _____

Nitrification Field: No Fields 1 Square Feet 810 Linear Feet 270

No Lines 6 @ 45' Trench Width 24"-36" Max Trench Bottom Depth 36" Gravel Depth —

☒ New System ☐ Repair System Type: I, II, (III), IV, V, VI

System Description: Gravity Panel Block

Repair System Description: 100% LP Panel Block

Maintenance Agreement Required: ☐ Yes ☒ No

☒ House/Mod. Home ☐ Mobile Home ☐ Business ☐ Other

No. Bedrooms 4 No. Bathrooms 2½ No. Employees _____


☐ Slab ☒ Crawl Space ☐ Basement w/plumbing ☐ Basement wo/plumbing

Water Supply: ☒ Individual ☐ Public ☐ Community Shared Well


Comments/Conditions:

Comments/Conditions:

INITIAL SITE SKETCH

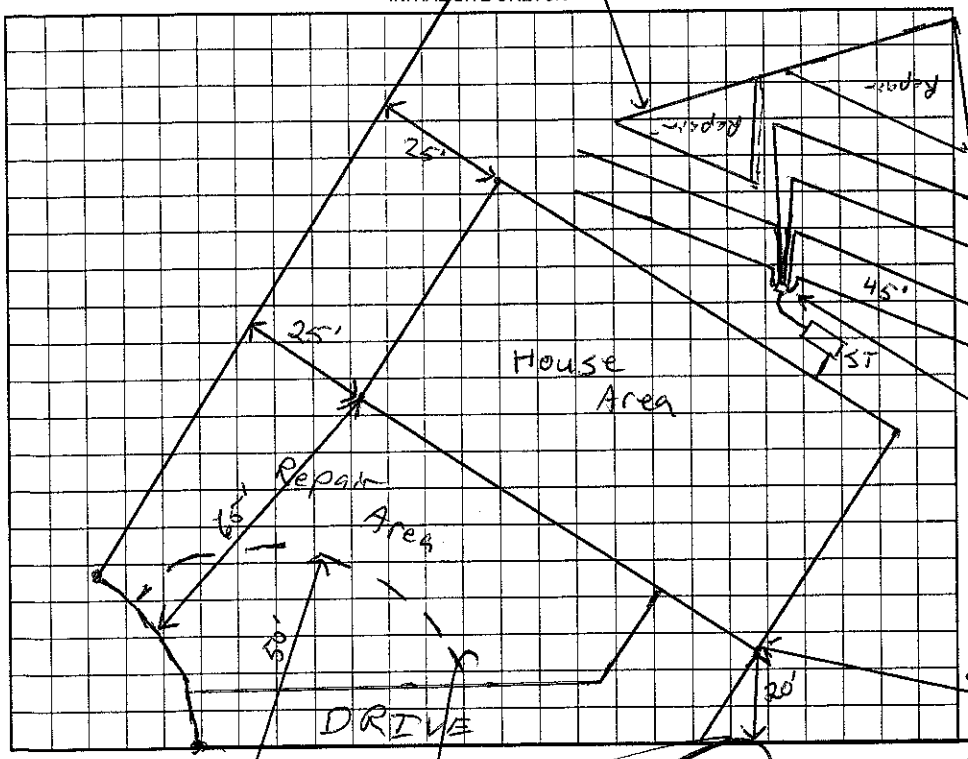

AS BUILT SKETCH

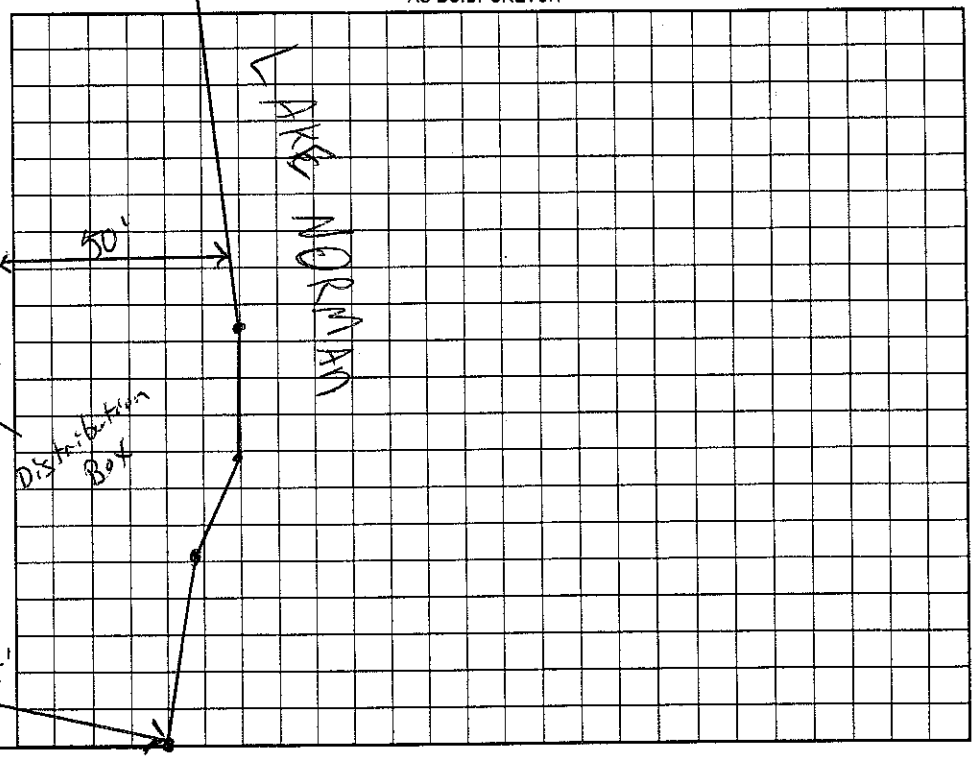

Permit can be suspended or revoked if any false information is supplied toward securing the permit/any unauthorized changes are made to the site/any unauthorized changes are made in the installation of the system. Improvement Permit with plat valid without expiration. Improvement Permit with site plan valid for sixty months. Authorization to Construct is valid for a period equal to that of Improvement Permit – not to exceed sixty months.

Signed: _____ date 4-18-01 Installed by: Mitchell Hawkins Grading

Improvement Permit by: _____ date 4/17/01 Operation Permit by: _____ date 2/15/02

Authorization to Construct by: _____ date 4/17/01 Existing System Inspection by: _____ date _____

HEALTH DEPT. COPY: WHITE OWNER COPY (FINAL): YELLOW OWNER COPY (INITIAL): PINK