IREDELL COUNTY HEALTH DEPARTMENT 4628825104

12132 (SEPTIC TANK) IMPROVEMENTS PERMIT AND CERTIFICATE OF COMPLETION
(Ground Absorption Sewage Disposal System -- G. S. Chapter 130-Article 13C)

OWNER OR CONTRACTOR Daniel Waddell DATE Nov 5, '90 PERMIT NO 2N-3-A-298

PHONE: Business _____ Home _____

LOCATION 150W TR 1438 (Waddell Rd) At end on right S. R. No. _____

SUBDIVISION NAME CLFT LAKE NORMAN LOT NO. 298 SECTION OR BLOCK NO. 11


House (✓) Mobile Home ( ) Business ( ) Other _____

No. Bedrooms 3 No. Bathrooms 2

Garbage Disposal Unit	Yes ( )	No (✓)	Character & Porosity of Soil	
Auto. Dishwasher	Yes (✓)	No ( )	Percolation Rate	
Auto. Wash. Machine	Yes (✓)	No ( )	Topography	
Site Suitable	Yes ( )	No ( )	Depth to Water Table	CABLE
			Rock or other impervious formations	

Lot Area Existing

✓ Basement with Plumbing ____ Basement without Plumbing ____ No Basement

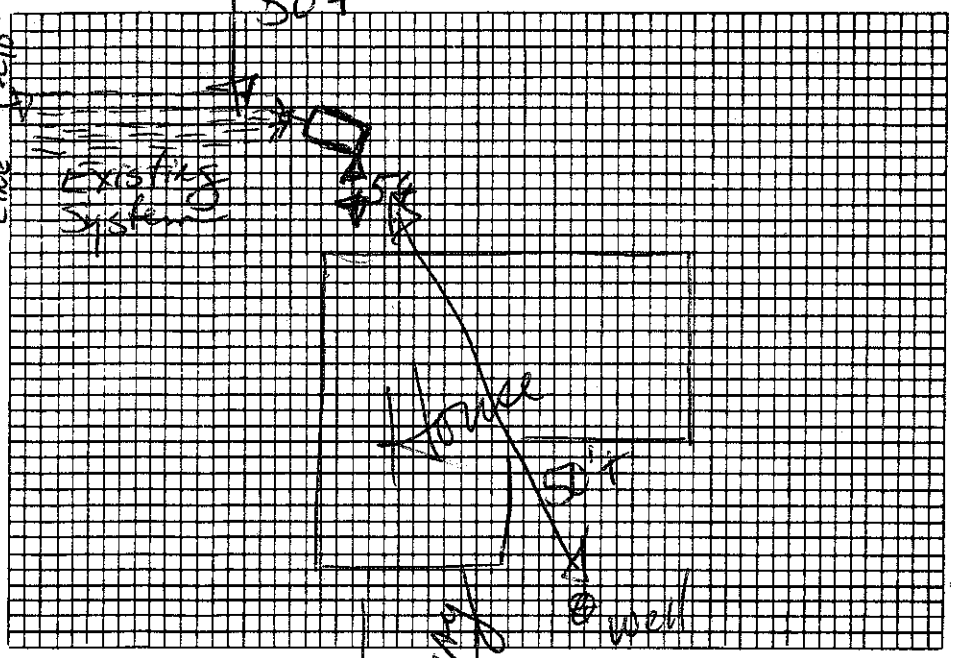

Plan of System

Size of Tank Existing Gals.
Nitrification Field:
No. of Lines Existing
Sq. Ft. _____ Linear Ft. _____
Depth of Stone in Lines _____
Water Supply: Individual (✓)
Public ( )

Installed by _____

I understand and agree to install septic tank system as specified on this Improvements Permit.

Signed: _____

IMPROVEMENTS PERMIT BY _____

COMMENTS: _____

Waddell Road

Existing system showing no sign of malfunction at time of inspection

CERTIFICATE OF COMPLETION BY _____ DATE _____

EXISTING SYSTEM CHECKED BY: D. R. Hunsucker DATE 11-5-90

CONSTRUCTION MUST COMPLY WITH ALL OTHER APPLICABLE STATE AND LOCAL REGULATIONS.

Permit is VOID if any unauthorized changes are made in installation of system and/or if any false information is supplied in making Improvements Permit.

Health Dept. Copy: White Inspection Dept. Copy: Yellow Sanitarian's Copy: Pink Owner's Copy: Gold

IREDELL COUNTY HEALTH DEPARTMENT

(SEPTIC TANK) IMPROVEMENTS PERMIT AND CERTIFICATE OF COMPLETION
(Ground Absorption Sewage Disposal System -- G. S. Chapter 130-Article 13C)

OWNER OR CONTRACTOR John Hale DATE 8-27-80 PERMIT NO. 268

PHONE: Business _____ Home _____

LOCATION 150 W TR 1438 Atent on R


SUBDIVISION NAME Lake Norman LOT NO. 298 S. R. No. _____ SECTION OR BLOCK NO. 11

House (X) Mobile Home (X) Business ( ) Other Adding on to house

No. Bedrooms 3 No. Bathrooms 2

Garbage Disposal Unit	Yes ( )	No (X)	Character & Porosity of Soil	weathered PARENT material
Auto. Dishwasher	Yes (X)	No ( )	Percolation Rate	80-120 MPI
Auto. Wash. Machine	Yes (X)	No ( )	Topography	~~20~~ 8%
Site Suitable	Yes (X)	No ( )	Depth to Water Table	10 ft
Lot Area ~3/4 Acre			~~Rock~~ or other impervious formations	NONE observed

Basement with Plumbing ____ Basement without Plumbing ____ No Basement (X)

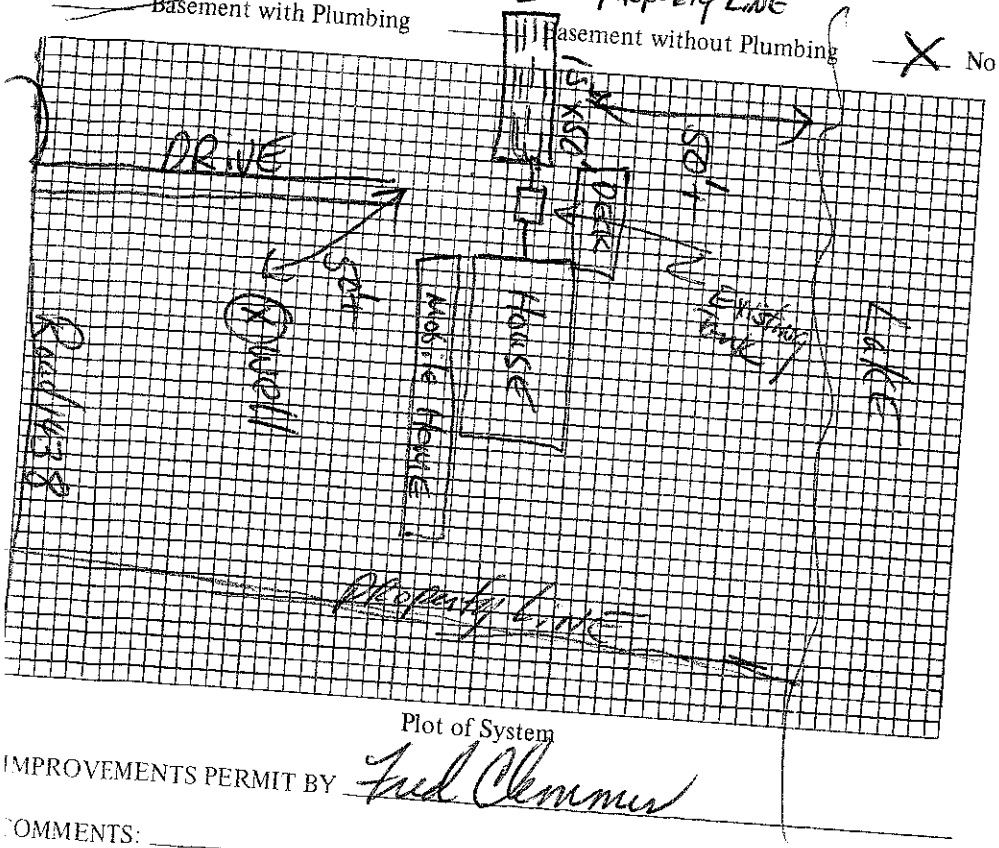

Plot of System

Size of Tank Existing Gals.
Nitrification Field:
No. of Lines 5
Sq. Ft. 750 Linear Ft. 250
Depth of Stone in Lines 16"
Water Supply: Individual (X)
Public ( )

Installed by F. J. Ervin Co.

I understand and agree to install septic tank system as specified on this Improvements Permit.

Signed: _____

IMPROVEMENTS PERMIT BY Fred Clemmer

COMMENTS: _____

ERTIFICATE OF COMPLETION BY Fred Clemmer DATE 8-27-80

XISTING SYSTEM CHECKED BY: _____ DATE _____

CONSTRUCTION MUST COMPLY WITH ALL OTHER APPLICABLE STATE AND LOCAL REGULATIONS.
rmit is VOID if any unauthorized changes are made in installation of system and/or if any false information is supplied in making
provements Permit.

Health Dept. Copy: White Inspection Dept. Copy: Yellow Sanitarian's Copy: Pink Owner's Copy: Gold