IREDELL COUNTY HEALTH DEPARTMENT

STATESVILLE 704-878-5305 MOORESVILLE 704-664-5281

IMPROVEMENT PERMIT / AUTHORIZATION TO CONSTRUCT / OPERATION PERMIT / EXISTING SYSTEM INSPECTION

PERMIT# 141679 PIN# 4628 87 6471 DATE 4/24/07

OWNER OR APPLICANT Randall Lowery PHONE: Business 704-437-6370 Home

ADDRESS Statesville, NC.

LOCATION Perth Rd N TL Fern Hill TR Fern Haven Ln, last lot on (L) off Cul de sac

SUBDIVISION CL+T BLOCK / SECTION 15 LOT LOT AREA <43000 SITE CLASS. PS DESIGN FLOW 480 L.T.A.R. .3

Septic Tank: 1000 Gallons; STB Date

Pump Tank: 1000 Gallons; PT Date

Pump Make: Model Serial No.

Nitrification Field: No Fields 1 Square Feet 801 Linear Feet 167

No Lines 5@53' Trench Width 3' Max Trench Bottom Depth 3'

[X] New System [ ] Repair [ ] Expansion System Type: I II III (IV) V VI

System Description: LP-16" PPBRS

Repair System Description: <83 Lot

Maintenance Agreement Required: [ ] Yes [ ] No

[X] House/Mod. Home No. Bedrooms 4

[ ] Mobile Home No. Persons

[ ] Business No. Employees

[ ] Other

Water Supply: [X] Individual [ ] Public [ ] Community SHARED


Gravel Depth No [ ] Gravity [X] Pressure [ ] Slab [ ] Crawl Space [X] Basement w/plumbing [ ] Basement wo/plumbing

Comments:/Conditions:


15' 24'

Comments:/Conditions:

INITIAL SITE SKETCH

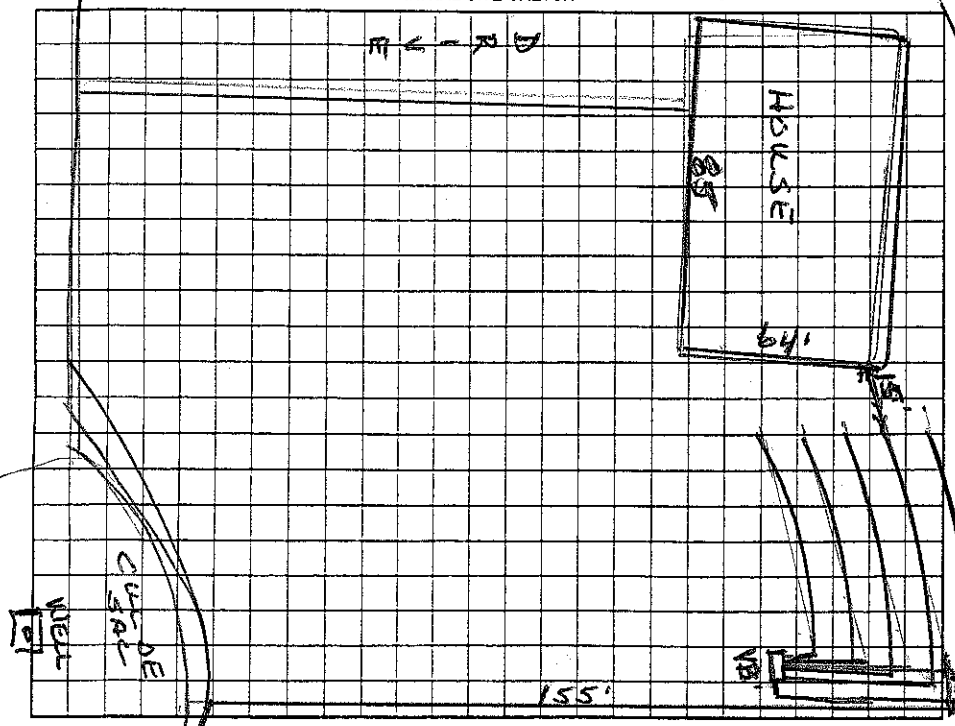

AS BUILT SKETCH

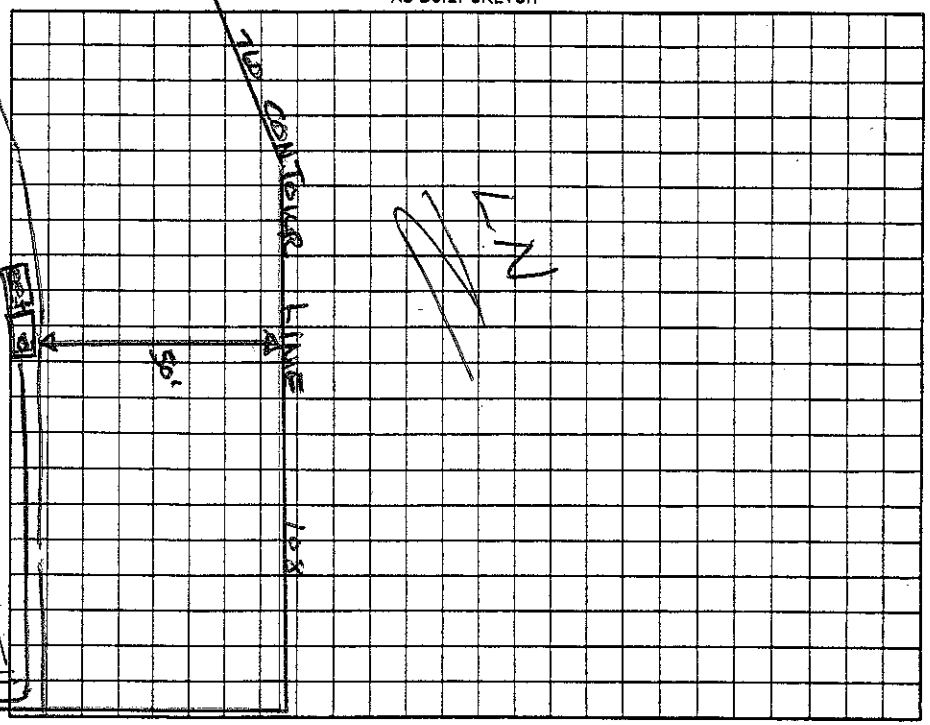

Permit can be suspended or revoked if any false information is supplied toward securing the permit/any unauthorized changes are made to the site/any unauthorized changes are made in the installation of the system. Improvement Permit with plat valid without expiration. [ ] Improvement Permit with site plan valid for sixty months [ ] Authorization to Construct is valid for a period equal to that of Improvement Permit – not to exceed sixty months.

Signed: [signature] date 5-1-07 Installed by:

Improvement Permit by: Wesley Sparks RS. date 4/24/07 Operation Permit by: date

Authorization to Construct by: Wesley Sparks RS. date 4/24/07 Existing System Inspection by: date

HEALTH DEPT. COPY: WHITE OWNER COPY (FINAL): YELLOW OWNER COPY (INITIAL): PINK