IREDELL COUNTY HEALTH DEPARTMENT

STATESVILLE 704-878-5305 $50.00 Paid MOORESVILLE 704-664-5281

4:00

IMPROVEMENT PERMIT / AUTHORIZATION TO CONSTRUCT / OPERATION PERMIT / EXISTING SYSTEM INSPECTION

PERMIT# 129929 PIN# 4628878451 DATE 11-29-05

OWNER OR APPLICANT James & Patricia Woods PHONE: Business 704-758-2625 Home 336-765-1586

ADDRESS 3720 Will Scarlett Rd. Winston-Salem NC 28714

LOCATION Perth Rd N, TL Fern Hill, TR Fern Haven, end of street on left 159 Fern Haven

SUBDIVISION _____ BLOCK / SECTION _____ LOT _____ LOT AREA .334 Ac SITE CLASS. PS DESIGN FLOW 360gpd L.T.A.R. .4 gpd / ft²

Septic Tank: 1000 Gallons; STB 1007 Date 11-14-05
Pump Tank: 1000 Gallons; PT 274 Date 1-24-06
Pump Make: ZOELLER Model BN 152-A Serial No. 1104
Nitrification Field: No Fields 1 Square Feet 900 Linear Feet 150
No Lines 4 Trench Width 24" Max Trench Bottom Depth 36"

☒ New System ☐ Repair ☐ Expansion System Type: I II III (IV) V VI
System Description: LP Panel
Repair System Description: LP Panel
Maintenance Agreement Required: ☒ Yes ☐ No

☒ House/Mod. Home No. Bedrooms 3
☐ Mobile Home No. Persons ____
☐ Business No. Employees ____
☐ Other ____

Water Supply: ☒ Individual ☐ Public ☐ Community


Gravel Depth NA ☐ Gravity ☒ Pressure ☒ Slab ☐ Crawl Space ☒ Basement w/plumbing ☐ Basement wo/plumbing

Comments/Conditions:
36 panels - 9 per line
Abandon existing tank & drainfield
Any new well must be 100' from tank or drainfield
& 25' from building foundation 112'

Common well


Comments/Conditions:
pump tank w/ riser
ST w/ risers black polylok filter
3-17-06 bottom 3 lines checked
Top line checked

INITIAL SITE SKETCH

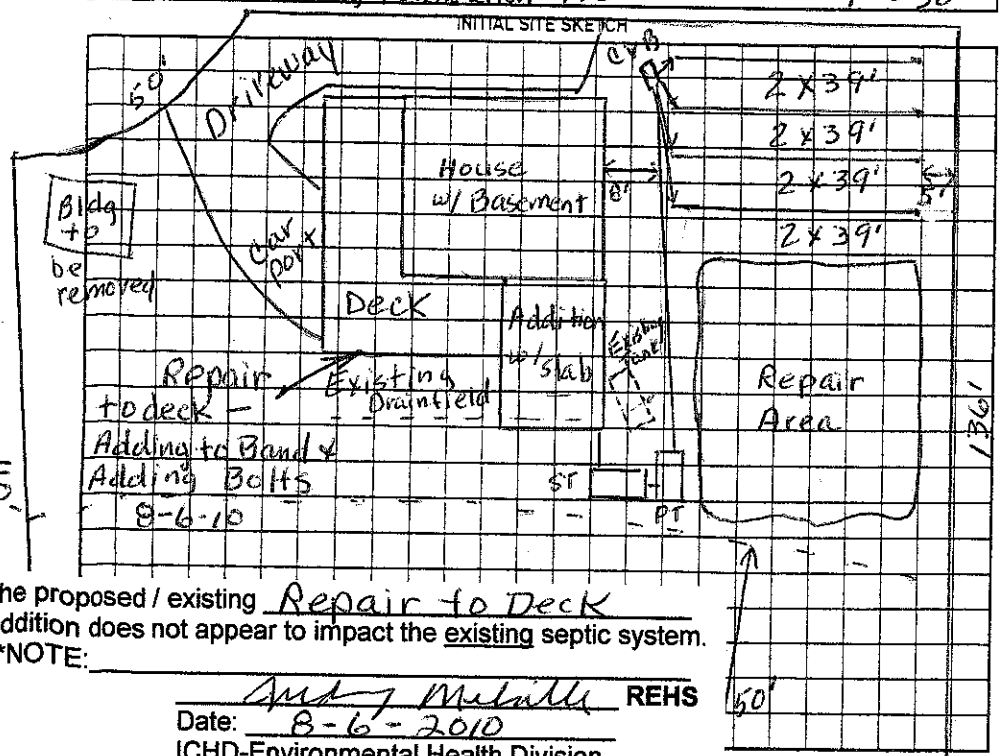

AS BUILT SKETCH

System installed as initial site sketch except for tanks as noted

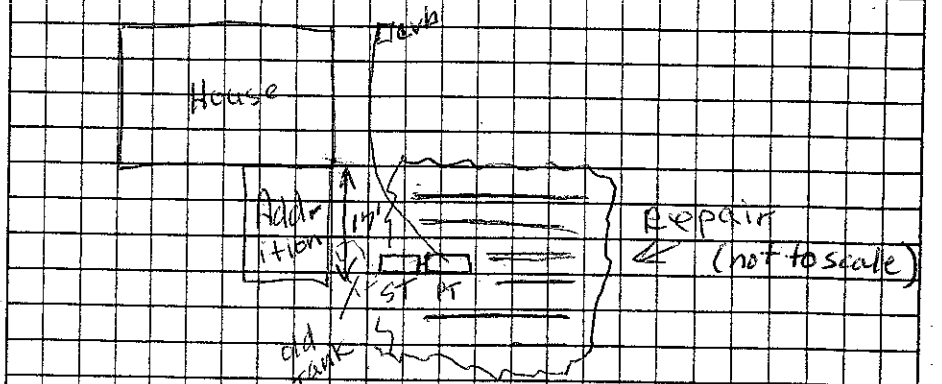

House addition built after septic installed

The proposed / existing Repair to Deck addition does not appear to impact the existing septic system.

**NOTE: _____

Judy McNeill REHS

Date: 8-6-2010

ICHD-Environmental Health Division

Permit with plat valid without expiration. ☐ Improvement Permit with site plan valid for sixty months. ☐ securing the permit/any unauthorized changes are made to the site/any unauthorized changes are made in the installation of the system. Improvement Authorization to Construct is valid for a period equal to that of Improvement Permit – not to exceed sixty months.

Signed: James W Woods date 12-1-2005 Installed by: Wayne Clontz

Improvement Permit by: Judy McNeill date 11-29-05 Operation Permit by: Judy McNeill date 12-8-06

Authorization to Construct by: Judy McNeill date 11-29-05 Existing System Inspection by: _____ date _____

Lake Norman

HEALTH DEPT. COPY: WHITE OWNER COPY (FINAL): YELLOW OWNER COPY (INITIAL): PINK