IREDELL COUNTY HEALTH DEPARTMENT

STATESVILLE 704-878-5305 MOORESVILLE 704-664-5281

850.00 Paid 4:00

IMPROVEMENT PERMIT / AUTHORIZATION TO CONSTRUCT / OPERATION PERMIT / EXISTING SYSTEM INSPECTION

PERMIT# 129929 PIN# 4628878451 DATE 11-29-05

OWNER OR APPLICANT James & Patricia Woods PHONE: Business 704-758-2625 Home 336-765-1586

ADDRESS 3720 Will Scarlett Rd. Winston-Salem NC 28714

LOCATION Perth Rd N, TL Fern Hill, TR Fern Haven, end of street on left 159 Fern Haven

SUBDIVISION _____ BLOCK / SECTION _____ LOT _____ LOT AREA .334 Ac SITE CLASS. PS DESIGN FLOW 360 gpd L.T.A.R. .4 gpd/ft²

Septic Tank: 1000 Gallons; STB 10057 Date 11-14-05
Pump Tank: 1000 Gallons; PT 274 Date 1-24-06
Pump Make: ZOELLER Model BN 152-A Serial No. 1104
Nitrification Field: No Fields 1 Square Feet 900 Linear Feet 150
No Lines 4 Trench Width 24" Max Trench Bottom Depth 36" Gravel Depth NA ☐ Gravity ☒ Pressure

☒ New System ☐ Repair ☐ Expansion System Type: I II III (IV) V VI
System Description: LP Panel
Repair System Description: LP Panel
Maintenance Agreement Required: ☒ Yes ☐ No

☒ House/Mod. Home No. Bedrooms 3
☐ Mobile Home No. Persons ____
☐ Business No. Employees ____
☐ Other ____


Water Supply: ☒ Individual ☐ Public ☐ Community

☒ Slab ☐ Crawl Space ☒ Basement w/plumbing ☐ Basement wo/plumbing


Comments:/Conditions: 36 panels - 9 per line
Abandon existing tank & drainfield
Any new well must be 100' from tank or drainfield
25' from building foundation 112' 1" = 30'
Common well

Comments:/Conditions: pump tank w/riser
ST w/risers black polylok filter
3-17-06 bottom 3 lines checked
Top line checked

INITIAL SITE SKETCH

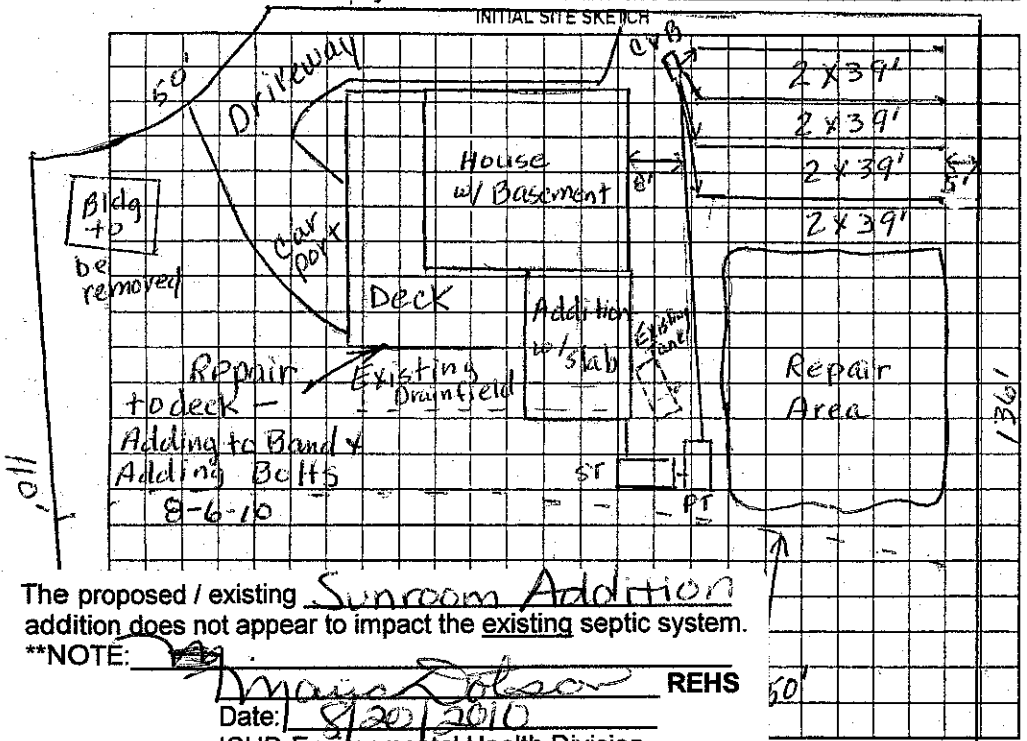

AS BUILT SKETCH

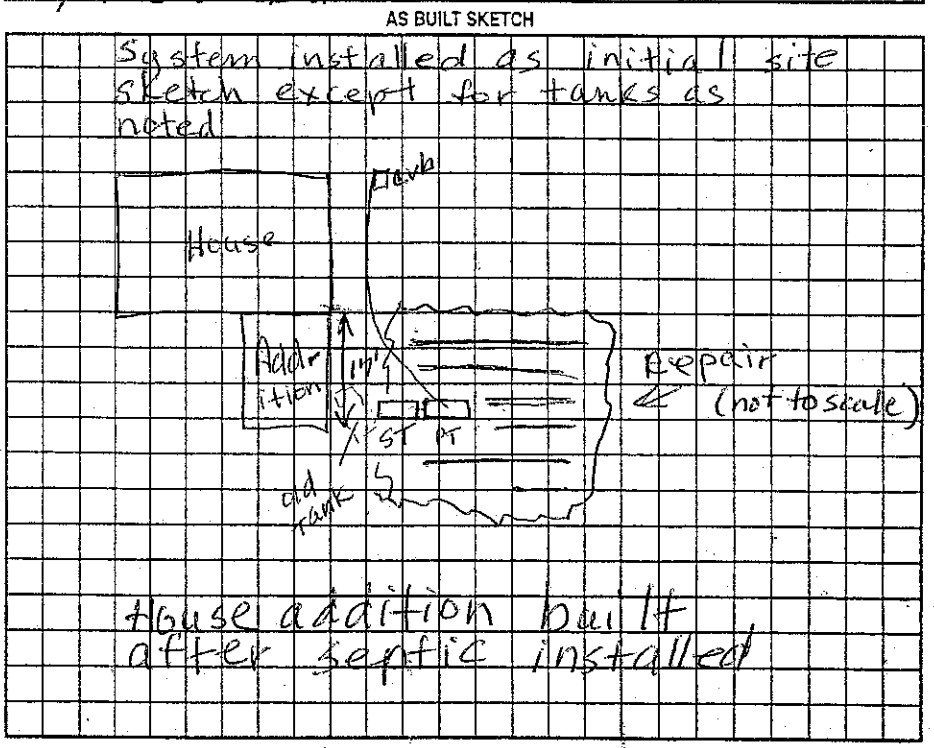

The proposed / existing Sunroom Addition addition does not appear to impact the existing septic system.

**NOTE: _____

Maggie Tolson REHS

Date: 8/20/2010

ICHD-Environmental Health Division

Permit can be suspended or revoked if any false information is supplied [illegible] securing the permit/any unauthorized changes are made to the site/any unauthorized changes are made in the installation of the system. Improvement Permit with plat valid without expiration ☐ Improvement Permit with site plan valid for sixty months ☐ Authorization to Construct is valid for a period equal to that of Improvement Permit – not to exceed sixty months.

Signed: James W Woods date 12-1-2005 Installed by: Wayne Clontz

Lake Norman

Improvement Permit by: Judy McNeill date 11-29-05 Operation Permit by: Judy McNeill date 12-8-06

Authorization to Construct by: Judy McNeill date 11-29-05 Existing System Inspection by: _____ date _____

HEALTH DEPT. COPY: WHITE OWNER COPY (FINAL): YELLOW OWNER COPY (INITIAL): PINK