IREDELL COUNTY HEALTH DEPARTMENT

STATESVILLE 704-878-5305 MOORESVILLE 704-664-5281

IMPROVEMENT PERMIT / AUTHORIZATION TO CONSTRUCT / OPERATION PERMIT / EXISTING SYSTEM INSPECTION

PERMIT# 14747 PIN# 4628893573 DATE 8/31/07

OWNER OR APPLICANT CHAD GOODIN SIGNATURE HOMES, INC PHONE: Business 704 363-7302 Home

ADDRESS 684 Normandy Rd MOORESVILLE NC 28117

LOCATION 21 SOUTH (R) NORTH (L) State PARK (L) Morrison FARM GO AROUND Circle OUT PAST Winston WAY

SUBDIVISION Morrison Pt BLOCK / SECTION LOT 19 LOT AREA 1.606 AC SITE CLASS. PS DESIGN FLOW 480 L.T.A.R. 13

Septic Tank: 1000 Gallons; STB 1017 Date 4-27-07

Pump Tank: 1000 Gallons; PT 1017 Date 7-10-07

Pump Make: Model Serial No

Nitrification Field: No Fields 1 Square Feet 600/600 Linear Feet 270"

No Lines 6 Trench Width 24" Max Trench Bottom Depth 36"

☒ New System ☐ Repair ☐ Expansion System Type: I II III (IV) V VI

System Description: LOW Pressure 50% REDUCT

Repair System Description: NO REPAIR

Maintenance Agreement Required: ☒ Yes ☐ No

☒ House/Mod. Home ☐ Mobile Home ☐ Business ☐ Other

No. Bedrooms 4 No. Persons 8 No. Employees

Water Supply: ☒ Individual ☐ Public ☐ Community

Gravel Depth #4 ☐ Gravity ☒ Pressure ☐ Slab ☐ Crawl Space ☒ Basement w/plumbing ☐ Basement wo/plumbing

Comments/Conditions: (1) Keep Have Out of Ground & BACKFILL FOR POSITIVE DRAINAGE (2) Install Lines ON CONTOUR & MAINTAIN SETBACKS (3) LOT IS Extremely tight on space.

Comments/Conditions:

INITIAL SITE SKETCH

SEE ATTACHED SYSTEM DESIGN BY [redacted] MICHAEL ATHANAS & ASSOCIATES, INC

AS BUILT SKETCH

Permit can be suspended or revoked if any false information is supplied toward securing the permit/any unauthorized changes are made to the site/any unauthorized changes are made in the installation of the system. Improvement Permit with plat valid without expiration ☐ Improvement Permit with site plan valid for sixty months ☒ Authorization to Construct is valid for a period equal to that of Improvement Permit – not to exceed sixty months.

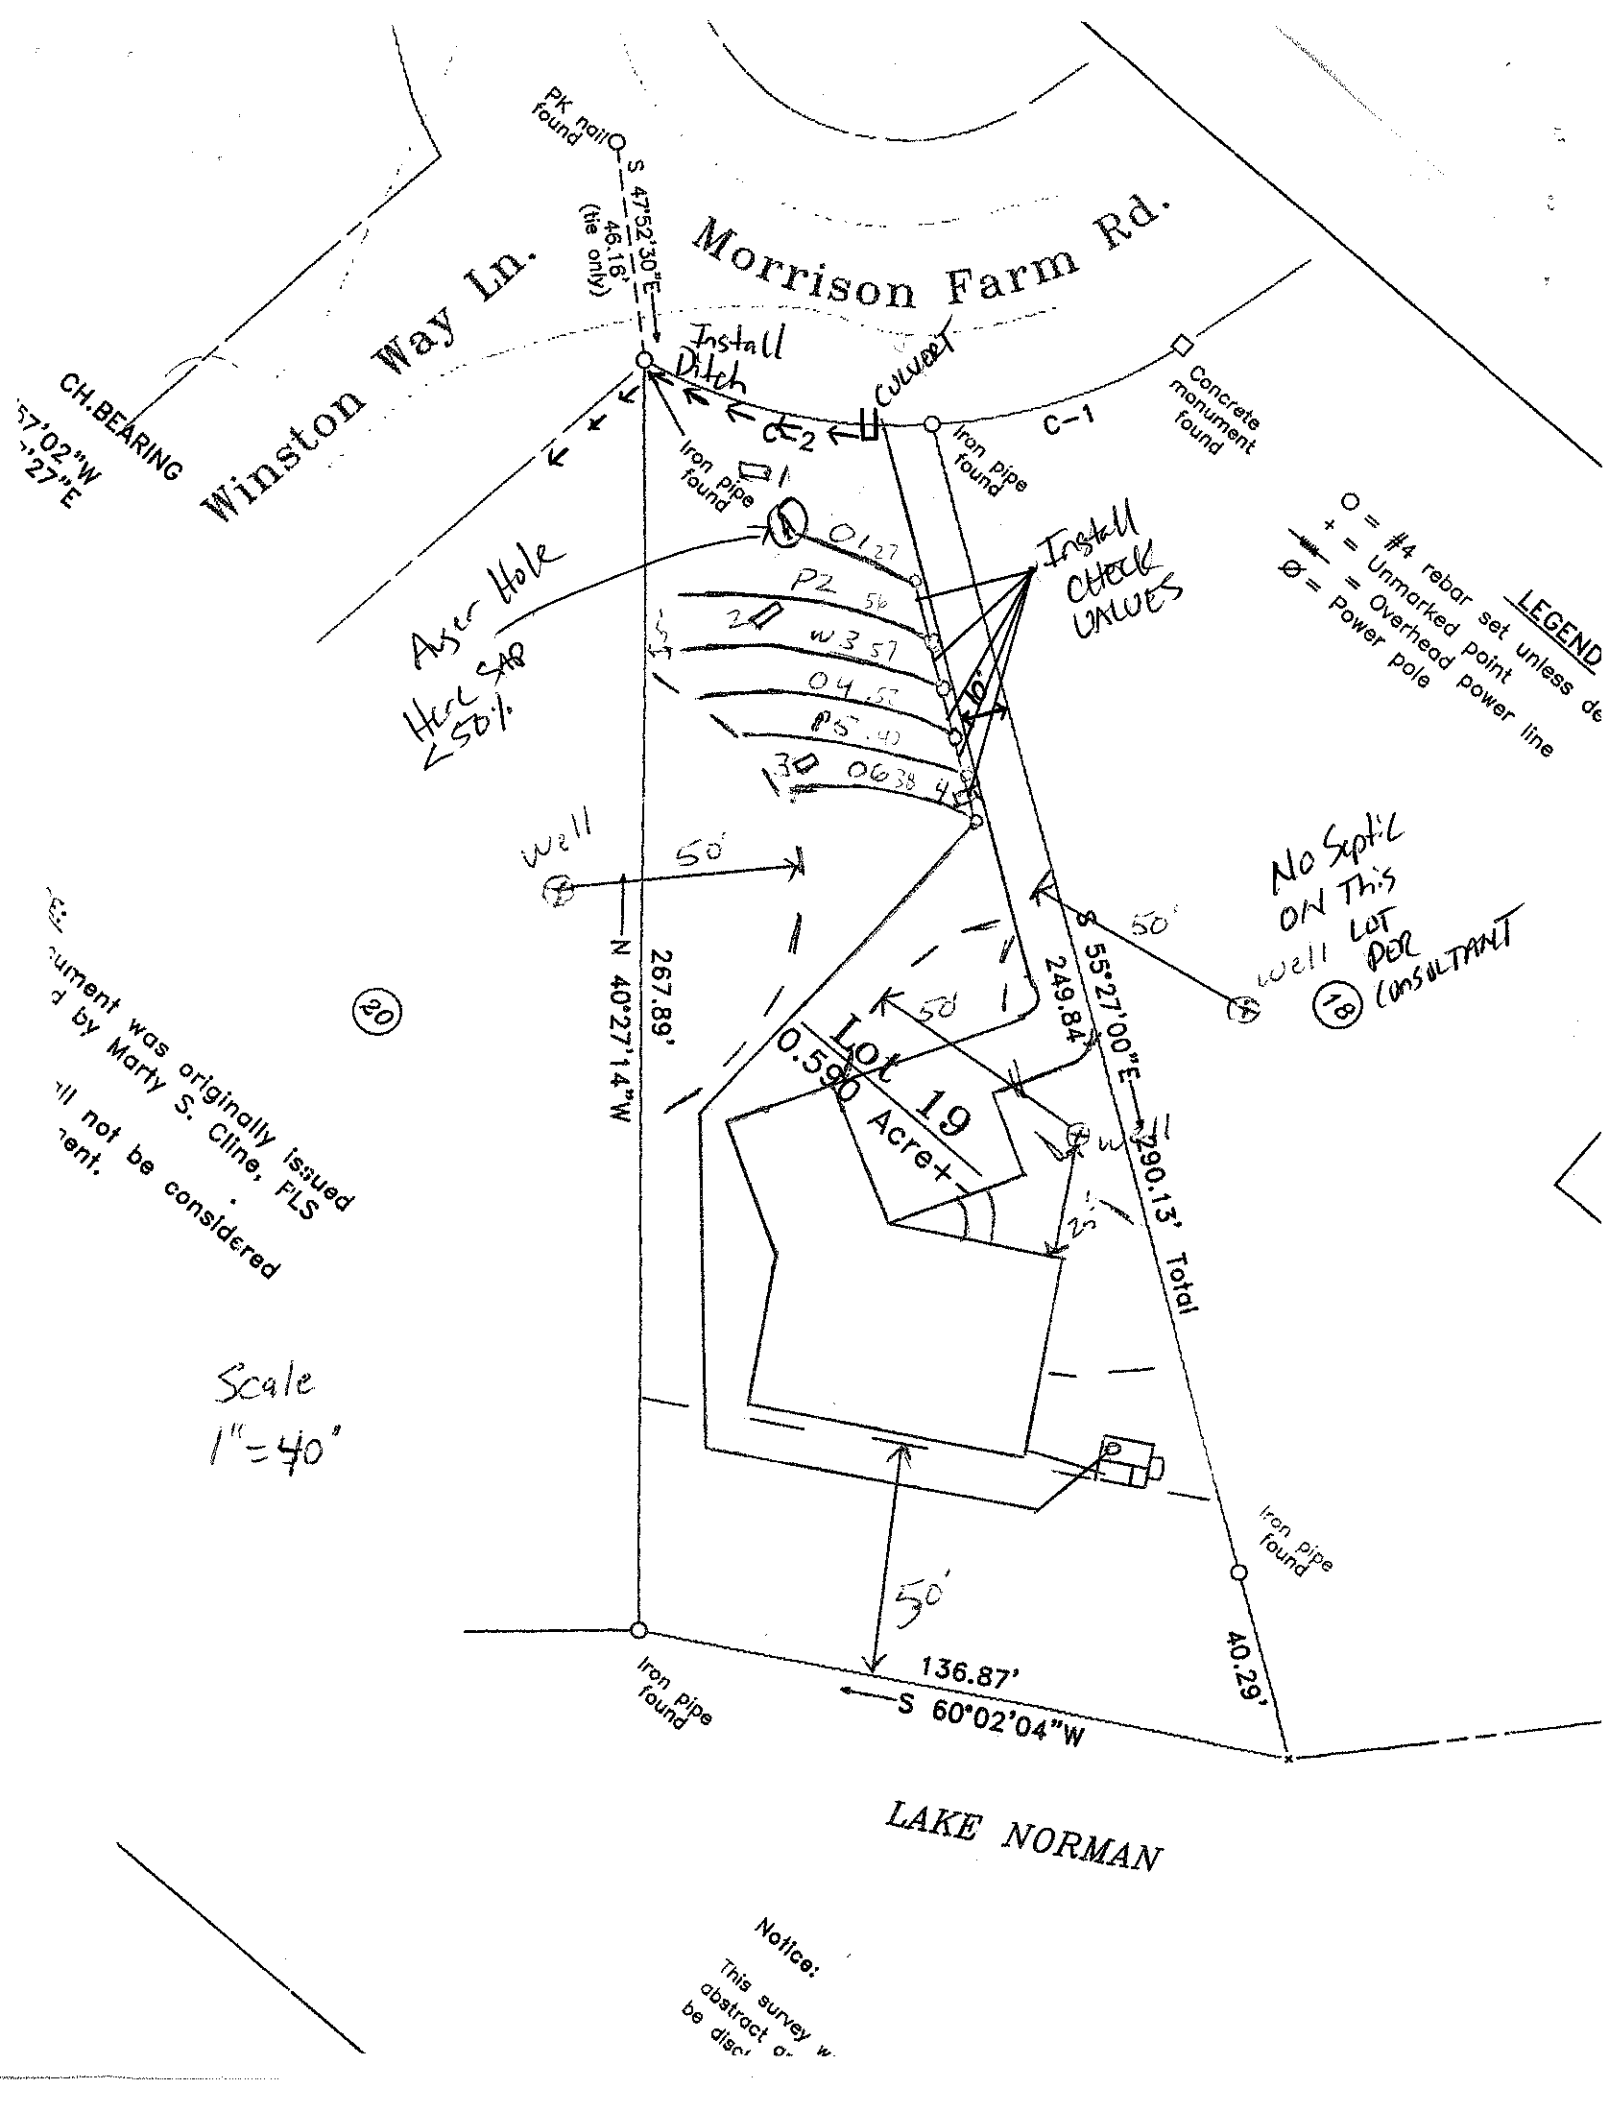
(*)

Signed: date 10/16/07 Installed by: C&S Grading

Improvement Permit by: date 9/5/07 Operation Permit by: date 10/9/07

Authorization to Construct by: date 9/5/07 Existing System Inspection by: date

HEALTH DEPT. COPY: WHITE OWNER COPY (FINAL): YELLOW OWNER COPY (INITIAL): PINK


Winston Way Ln.
Morrison Farm Rd.
PK nail found
S 47°52'30"E
46.16'
(tie only)
CH.BEARING
Install Ditch
Culvert
C-2
C-1
Iron pipe found
Concrete monument found
Aser Hole Here Sep 150'
Install check valves
LEGEND
= #4 rebar set unless de
= Unmarked point
= Overhead power line
= Power pole
Well
50'
N 40°27'14"W
267.89'
No Septic ON This well LOT PER CONSULTANT
(18)
(20)
S 55°27'00"E
249.84'
290.13' Total
Lot 19
0.590 Acre+-
25'
50'
136.87'
S 60°02'04"W
40.29'
Iron pipe found
LAKE NORMAN
Scale
1"=40'
ument was originally issued
d by Marty S. Cline, PLS
ll not be considered
ent.
Notice:
This survey w
abstract o
be disc