IREDELL COUNTY HEALTH DEPARTMENT

Statesville Phone TR 3-7271 Mooresville Phone No. 664-5281

PERMIT TO INSTALL SEPTIC TANK

Permit No. 14 Permit Date 2-21 1973

Owner AVERY JONES Address STATESVILLE, N.C.

Installed By LACKEY BROS. Address STONY POINT, N.C


Location of Property Trantmon - Left on State Park Rd.
St. to Morrison Point.
LOT 15-16 -

Tank		Capacity		Length of Lines		Fixtures	
Block	( )	1000	( )	225'	( )	No. of Baths	(4)
Precast	(✓)	1250	(✓)	250'	( )	Dishwasher	( )
		1500	( )	Other 325'		Garbage Grdr.	( )
		Other				Other	

NOTIFY HEALTH DEPARTMENT AT LEAST EIGHT HOURS BEFORE TANK IS TO BE INSPECTED.

Final Inspection will 2-21 1973 Approved (✓) Disapproved ( )

Remarks

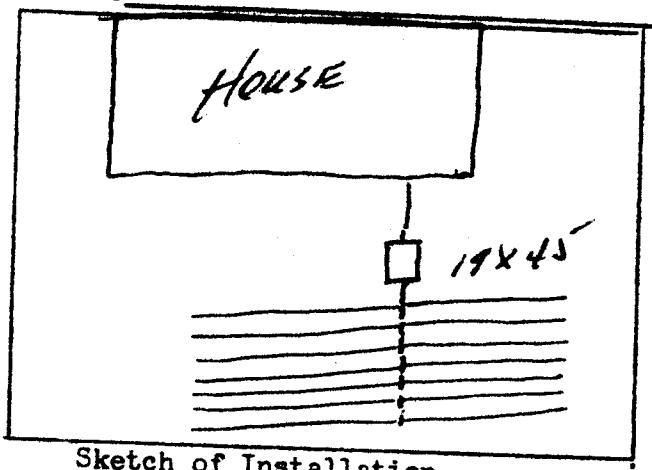

Sketch of Installation

Glenn Jr Rev

Sanitarian