IREDELL COUNTY HEALTH DEPARTMENT

STATESVILLE 704-878-5305 MOORESVILLE 704-664-5281

IMPROVEMENT PERMIT / AUTHORIZATION TO CONSTRUCT / OPERATION PERMIT / EXISTING SYSTEM INSPECTION

PERMIT # Repair PIN # 4628914108 DATE 3-18-2011

OWNER or APPLICANT David & Cheryl Klaft PHONE: Business Home:

OWNER or APPLICANT ADDRESS 132 Sawyer Ln Mooresville, NC 28115

LOCATION / DIRECTIONS Hwy 150 W. TR Waddell TR Hermance TL Sawyer at end in hole.

SUBDIVISION CLA T BLOCK / SECTION 11 LOT # 275 LOT AREA .73 AC DESIGN FLOW 360gpd L.T.A.R.

Septic Tank 1000 Gallons: STB 794 Date 2-4-11

Pump Tank Gallons: P T Date

Pump Make Model Serial #

Nitrification Field No. Fields 1 No. Lines Linear Feet 70?

Trench Width 1 1/2 Max. Trench Bottom Depth Gravel Depth

☐ New System ☒ Repair ☐ Expansion System Type I II III IV V VI

System Description: Gravity Conventional

Repair System Description: Modified? lot deeded prior to 1983

Maintenance Agreement Required ☐ YES ☐ NO

☒ GRAVITY ☐ PRESSURE

☒ Residence No. Bedrooms 3 ☐ Business No. Persons ☐ Other No. Employees


☐ Slab ☐ Crawl Space ☒ Basement w/plumbing ☐ Basement w/o plumbing

Water Supply: ☒ Private ☐ Public ☐ Community

Comments / Conditions: Existing ST Collapsed in. Therefore new ST had to be installed.

Comments / Conditions: Some dirt will be shaved off ST area & lower grade to within 1ft from top of tank to top of ground.

INITIAL SITE SKETCH

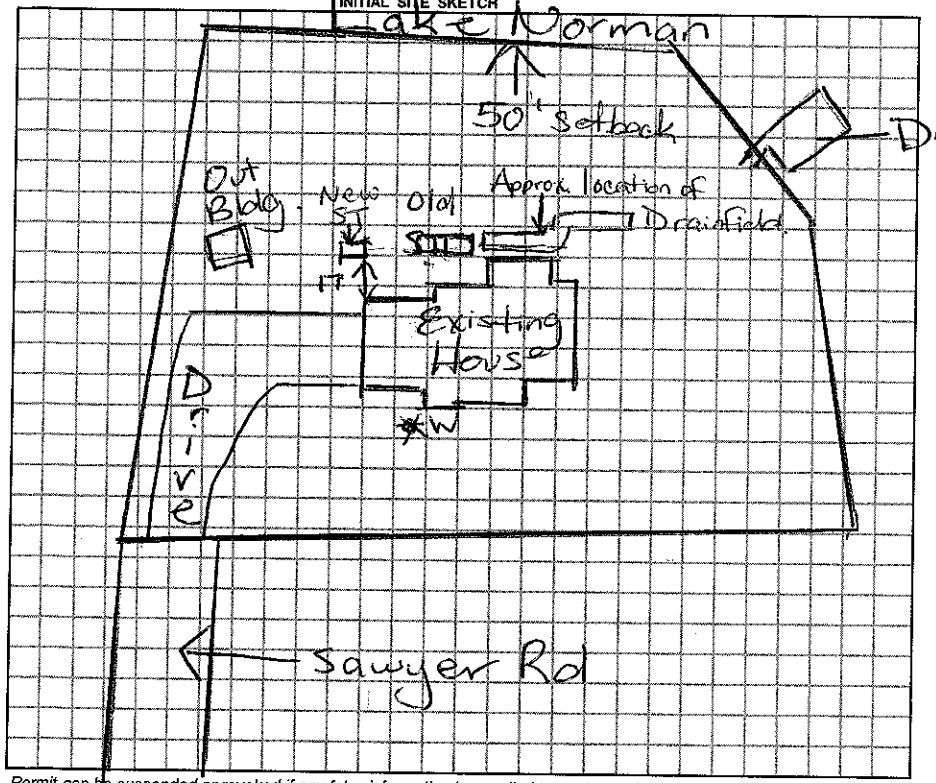

AS BUILT SKETCH

Permit can be suspended or revoked if any false information is supplied toward securing the permit / any unauthorized changes are made to the site / any unauthorized changes are made in the installation of the system.

☐ *IMPROVEMENT PERMIT w / plat valid without expiration.* ☐ *IMPROVEMENT PERMIT w / site plan valid for 60 mos.* ☐ *AUTHORIZATION TO CONSTRUCT valid for period equal to IMPROVEMENT PERMIT-not to exceed 60 mo.*

Owner / Applicant Signature: L B Cuppett Date

Improvement Permit by: Maintenance Johnson RS Date 3/18/11

Authorzation to Construct by: Maintenance Johnson RS Date 3/18/11

YOU SHOULD CONTACT A LOCATOR SERVICE PRIOR TO ANY EXCAVATION!

Installed by: R & H Maintenance Johnson RS

Operation Permit by: Maintenance Johnson RS Date: 3/18/11

Existing System Inspected by: Date:

WHITE COPY Environmental Health YELLOW COPY (Final) Owner / Applicant PINK COPY (Initial) Owner / Applicant

IREDELL COUNTY HEALTH DEPARTMENT

STATESVILLE 704-878-5305 MOORESVILLE 704-664-5281

IMPROVEMENT PERMIT / CERTIFICATE OF COMPLETION / OPERATION PERMIT / EXISTING SYSTEM INSPECTION

PROPERTY DESCRIPTION NO. 73447 (86017) DATE 5/27/98 TAX MAP NO. 4628 91 4108 Watershed: ☐ Yes ☒ No

OWNER OR CONTRACTOR Joe Weber PHONE: Business _____ Home 998-1762

ADDRESS 132 Sawyer Ln. Mooresville, NC. 28115

LOCATION 150W TR Waddell Rd. TL Sawyer Ln. 1st trailer on road.

SUBDIVISION C & T BLOCK / SECTION 11 LOT ~~NA~~ LOT AREA .734 SITE CLASS. PS DESIGN FLOW 360 L.T.A.R. _____

Septic Tank: EXISTING Gallons; STB _____ Date 275

Pump Tank: _____ Gallons; PT _____ Date _____

Pump Make: _____ Model _____ Serial No. _____

Nitrification Field: No Fields ___ Square ~~Feet~~ Existing System Linear Feet _____

No Lines _____ Trench Width _____ Max Trench Bottom Depth _____ Gravel Depth _____

☐ New System ☐ Repair System Type: I, ☒ II, III, IV, V, VI

System Description: EXISTING

Repair System Description: _____

Maintenance Agreement Required: ☐ Yes ☐ No

☐ House/Mod. Home ☒ Mobile Home ☐ Business ☐ Other

No. Bedrooms 3 No. Bathrooms 2 No. Employees ___

☐ Slab ☐ Crawl Space ☐ Basement w/plumbing ☐ Basement wo/plumbing


Water Supply: ☒ Individual ☐ Community ☐ Public

Comments:

Comments: 9/17/98 Reviewed plans appears in compliance with space requirements. Ok for up to 3 bedrooms WSparks

INITIAL SITE SKETCH

AS BUILT SKETCH

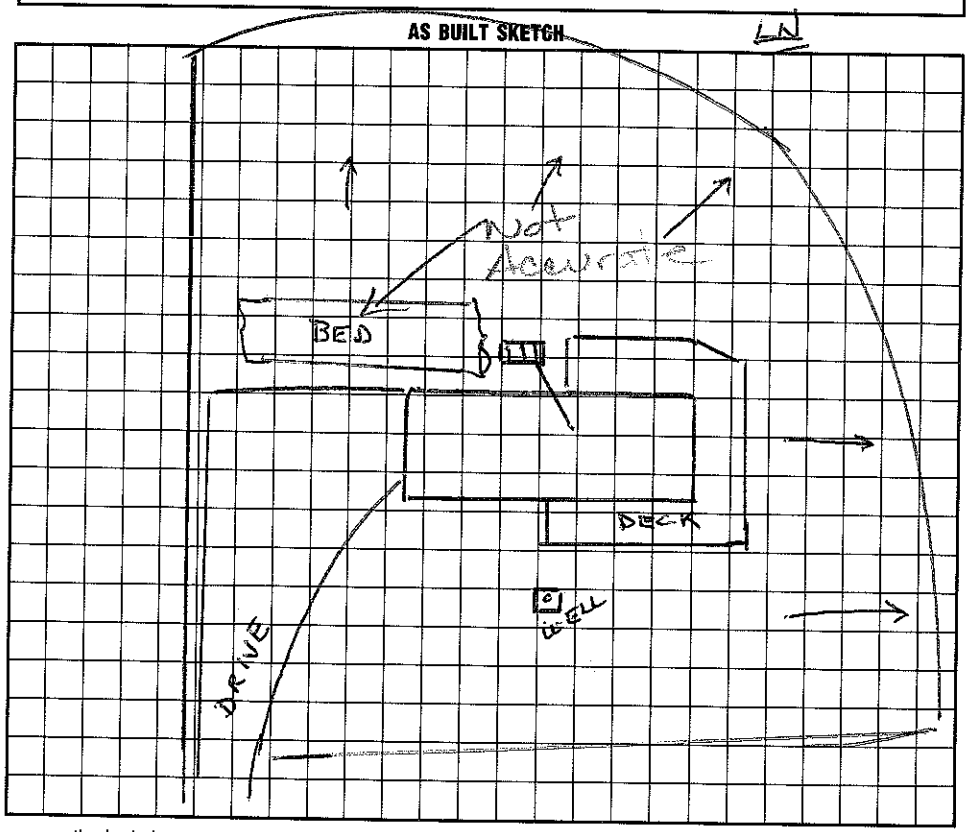

I understand that this permit can be suspended or revoked if any false information is supplied toward securing the permit/any unauthorized changes are made to the site/any unauthorized changes are made in the installation of the system. Improvement Permit is valid for 60 months from date of issuance.

Signed: _____

Improvement Permit by: _____ date _____

Existing System Inspection by: _____ date _____

Installed by: _____

~~Existing System~~ Certificate of Completion by: Wesley Sparks RS. date 5/27/98

Operation Permit by: Wesley Sparks RS. date 5/27/98

HEALTH DEPT. COPY: WHITE INSPECTION COPY (FINAL): GREEN OWNER COPY (FINAL): YELLOW INSPECTION COPY (INITIAL): PINK OWNER COPY (INITIAL): GOLD

Statesville ...COUNTY HEALTH ...PARTMENT
1271
Mooresville Phone No. 664-5281

PERMIT TO INSTALL SEPTIC TANK

Permit No. 194 Permit Date 8-3- 1973

Owner A. G. Abernathy Address Charlotte

Installed By Field Engineering Address Mooresville


Location of Property 15 W TR aster Rock
Quarry Stay Right at Forks next
left at end

Tank		Capacity		Length of Lines		Fixtures	
Block	( )	1000	( )	225'	(✓)	No. of Baths	(1)
Precast	(✓)	1250	( )	250'	( )	Dishwasher	(yes
		1500	( )	Other 195		Garbage Grdr.	(no
		Other				Other	

NOTIFY HEALTH DEPARTMENT AT LEAST EIGHT HOURS BEFORE TANK IS TO BE INSPECTED.

Final Inspection 8-3- 1973 Approved ( ) Disapproved ( )

Remarks Lay of lot and position of Trailer Prevented getting full 225' extra stone used in ditch.

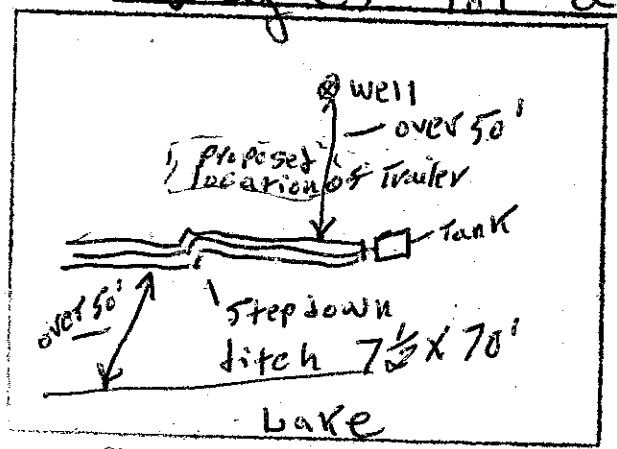

Sketch of Instal...

J. C. Moore